

I, Samuel O. Morris, of Plush Oregon, do hereby certify that this map was made from notes taken during an actual survey made by me on the (17th) Seventeenth day of May 1914 that it correctly represents the work described in the accompanying application (together with the location of the streams and ditches in the immediate vicinity) and has written thereon the area in each smallest legal subdivision which it is proposed to irrigate.

Samuel O Morris

Surveyor

T. 37. S. R. 23 E. W.M.

OFFICE OF STATE ENGINEER


RECEIVED

MAY 22 1914.

SALEM, . OREGON,

Application No. 3665

Permit No. 2075

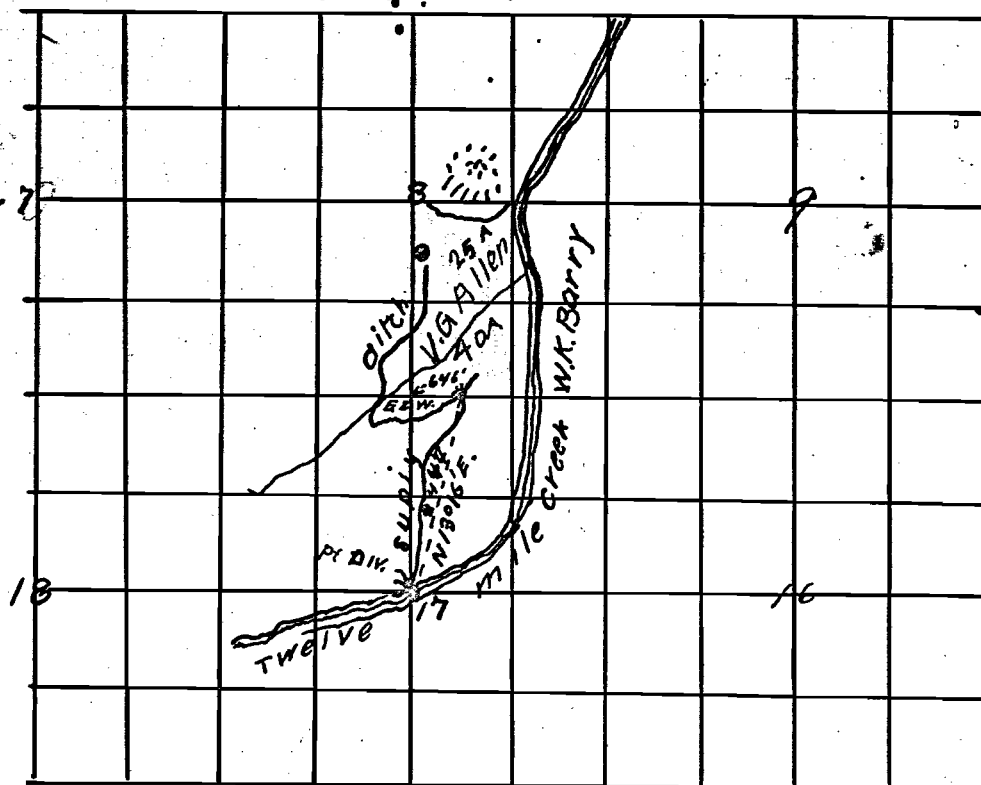

Scale 1 in = 1 mile

see

2075
C1975