


T.38S. R 11 1/2 E. W.M.

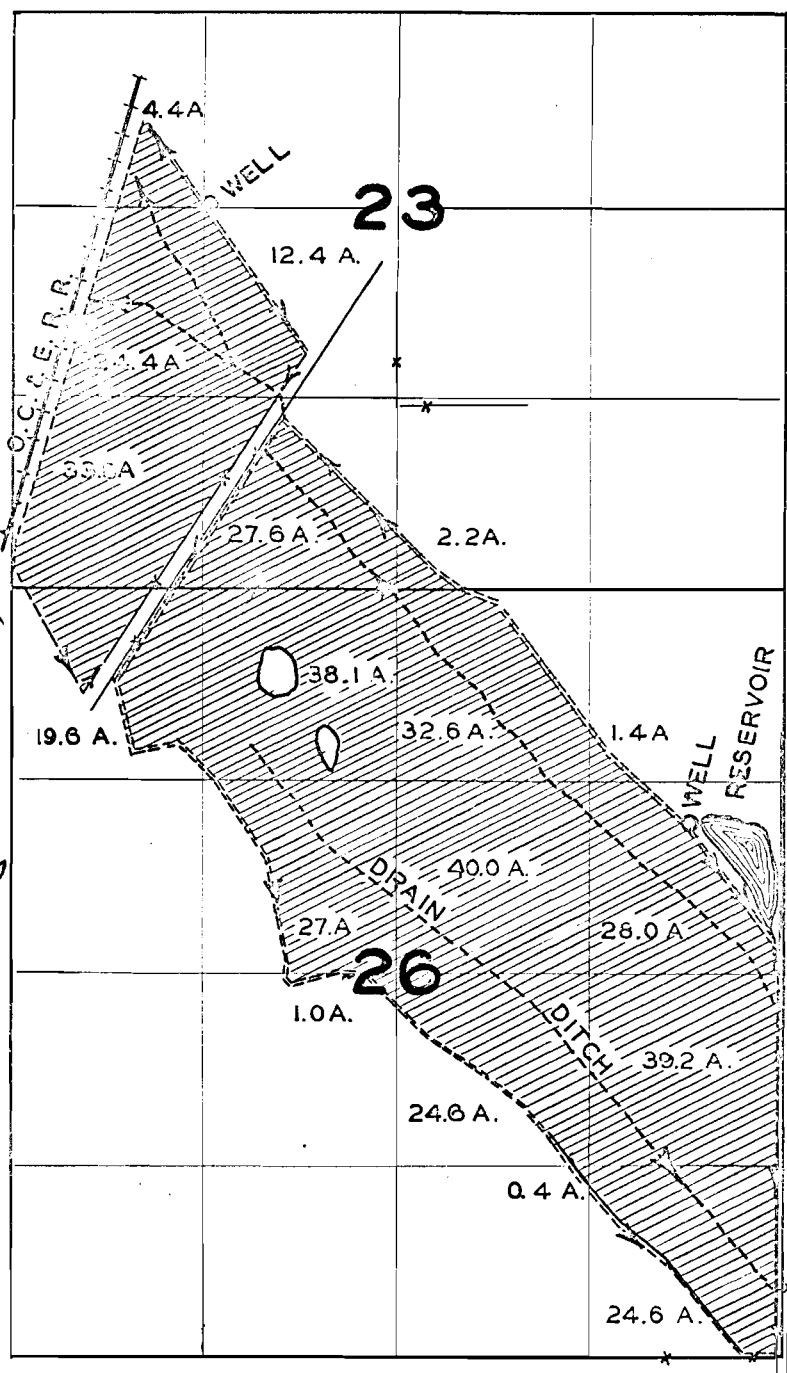

FINAL PROOF SURVEY

UNDER

U- 289

U- 263

Application No. U-264

Permit No. U-234

IN NAME OF

C. H. SEWALD

Surveyed MAY 17 1951, by H.L. COFFMAN