


T. I. S. R. I. W. W. M.

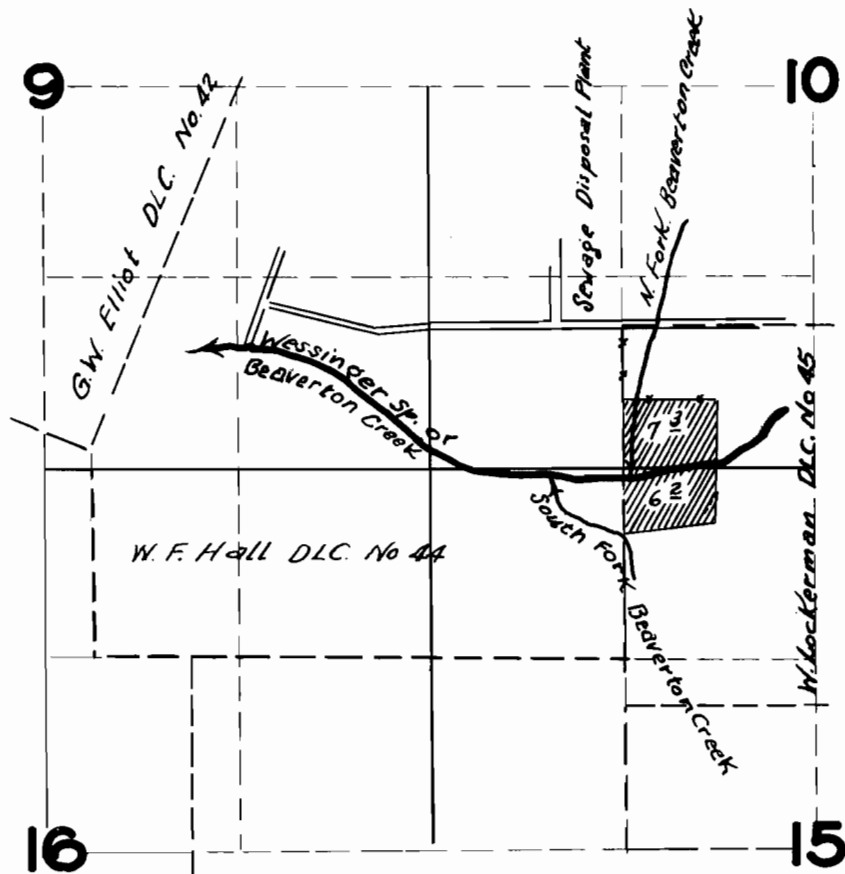

FINAL PROOF SURVEY

UNDER

Application No. 14364 Permit No. 15019

IN NAME OF

HATTI ROSSI

Surveyed 6/26 1951, by H.L. COFFMAN