


T.5 S. R. 5 W. W. M.

RECEIVED
APR 9 1975
STATE ENGINEER
SALEM, OREGON

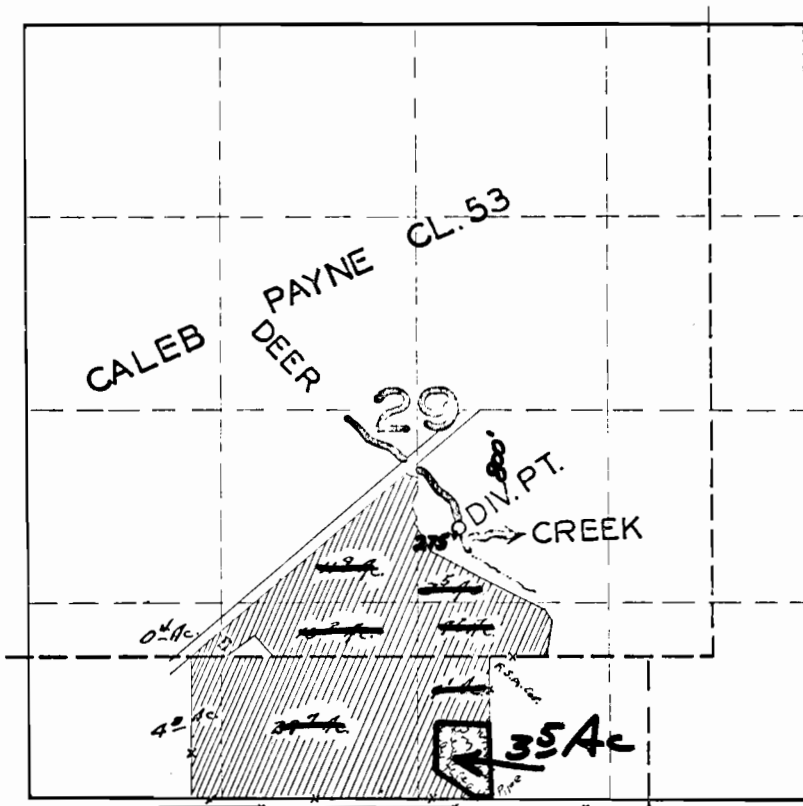

JAMES TONEY CL. 56

Scale 4" = 1 mile

FINAL PROOF OF SURVEY

181 29 13779
Application No. 176 65 Permit No. 13359
IN NAME OF

C. & C. TODD

Surveyed 9/27 1951, by H.L. COFFMAN

Application No. 52956
Permit No. 39978