


# T. 2S. R. 2W.W.M.

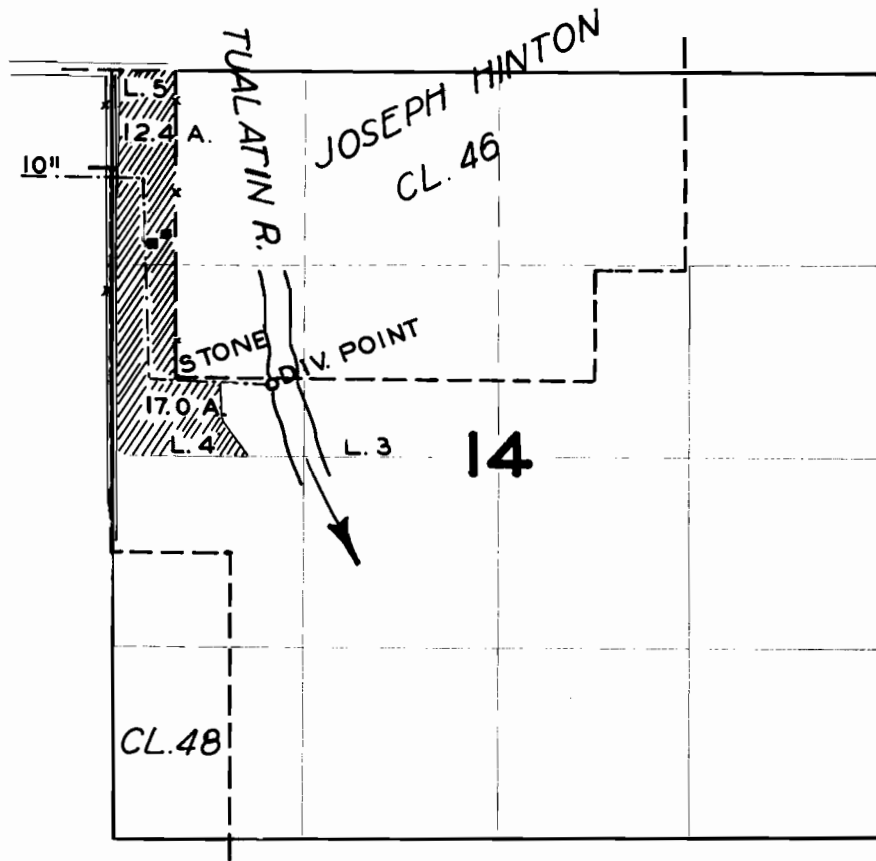

## FINAL PROOF SURVEY UNDER

Application No. 18165... Permit No. 13876...  
IN NAME OF

JESSE C. SNYDER

Surveyed JUNE 4, 1951, by H.L. COFFMAN