


# T. I. S. R. I. W. W. M.

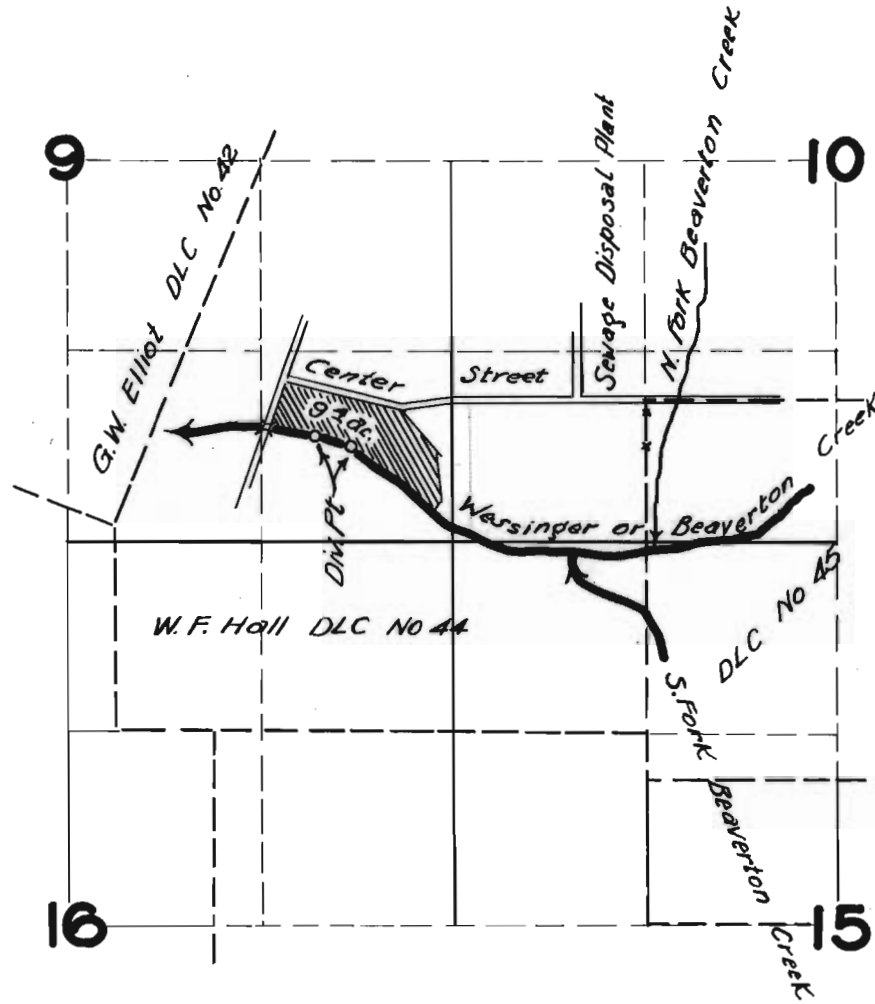

## FINAL PROOF SURVEY UNDER

Application No. 14368 Permit No. 15021

IN NAME OF

ROSE BIGGI

Surveyed 6/26 1951, by H.L. COFFMAN.