


T.4S.R.4W.W.M.

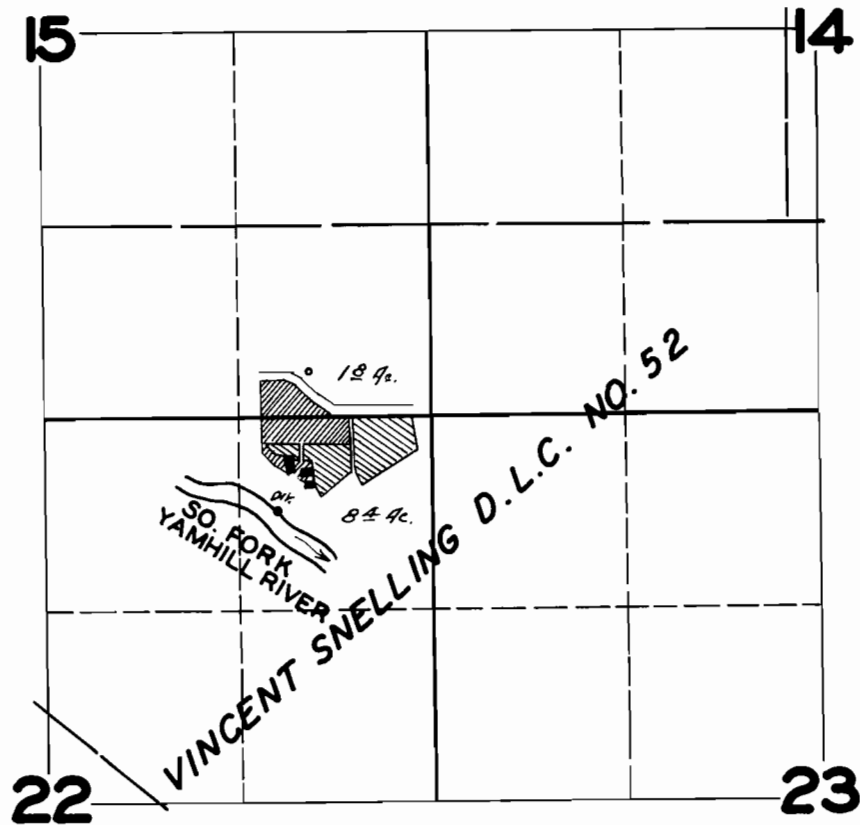

FINAL PROOF SURVEY

UNDER

Application No. 18265 ... Permit No. 13918 ...

IN NAME OF

ALBERT G. NOBLE

Surveyed MAR. 27, 1947, by JAS. E. BUNNELL