


160 N & 300 W from SE Cor NW NW

T.39S.R.20E.W.M.
APPLICATION NO.
18448 & 22155
PERMIT NO.
14072 & 17448
W. P. VERNON

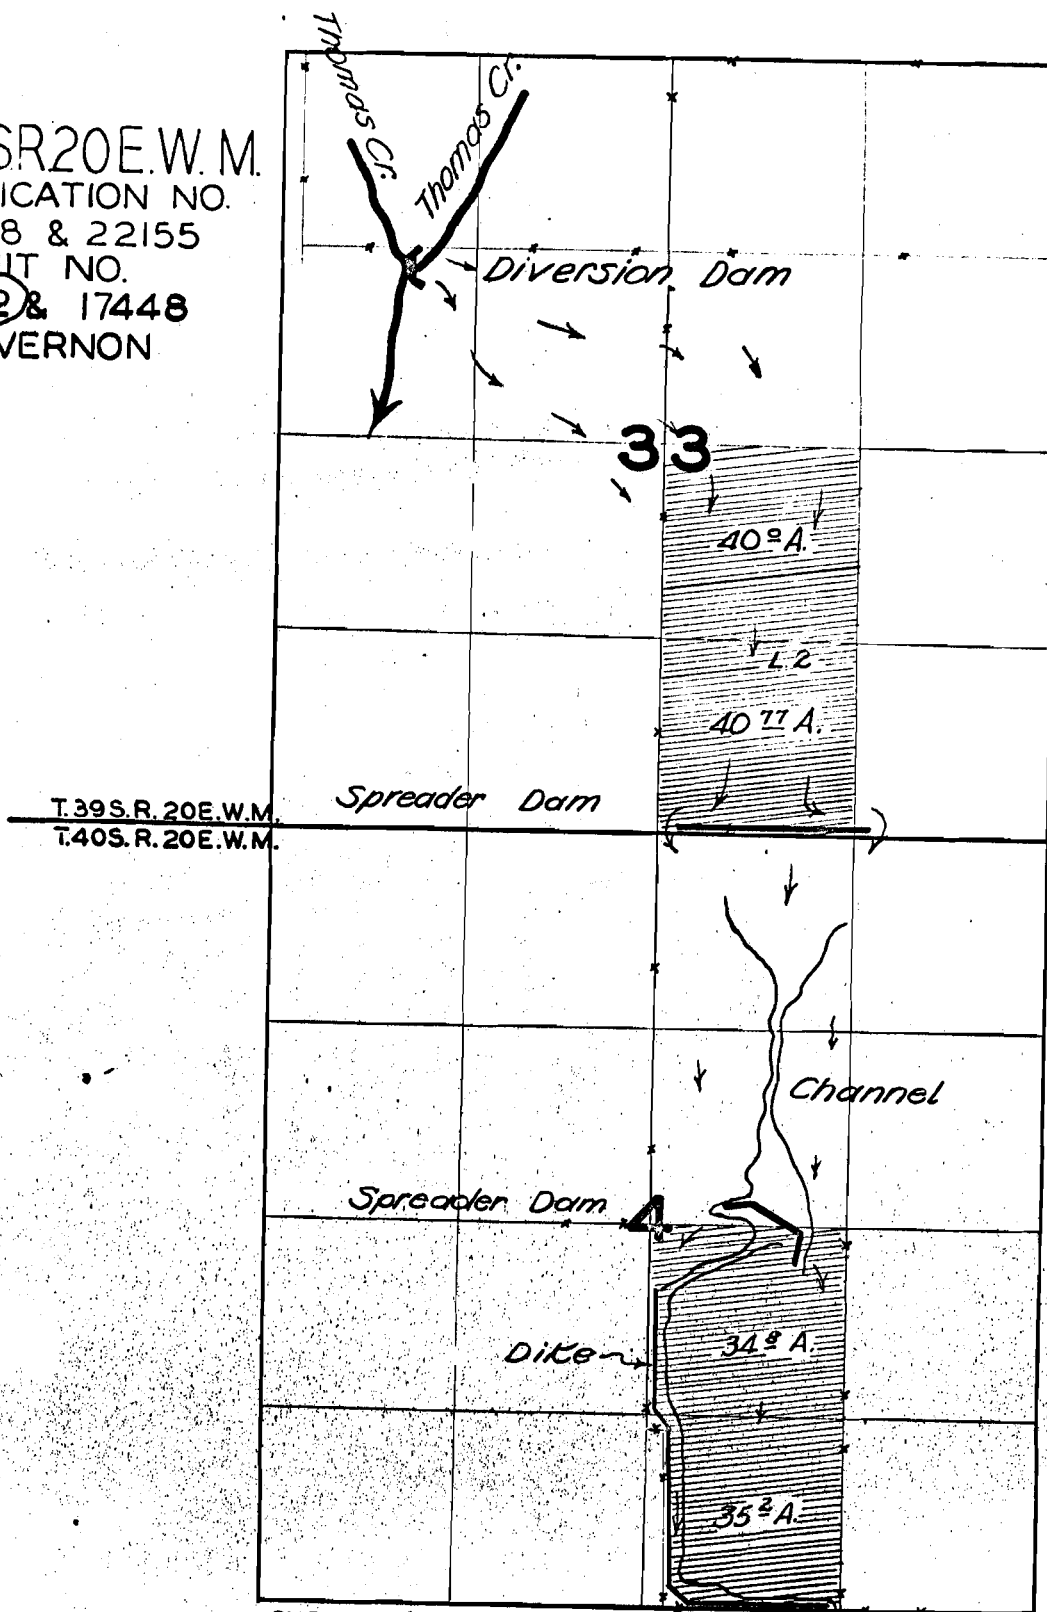

SURVEYED JUNE 20 1951
H. L. COFFMAN

1951 D

39-20 ✓