


T.2S. R.1 W.W.M.

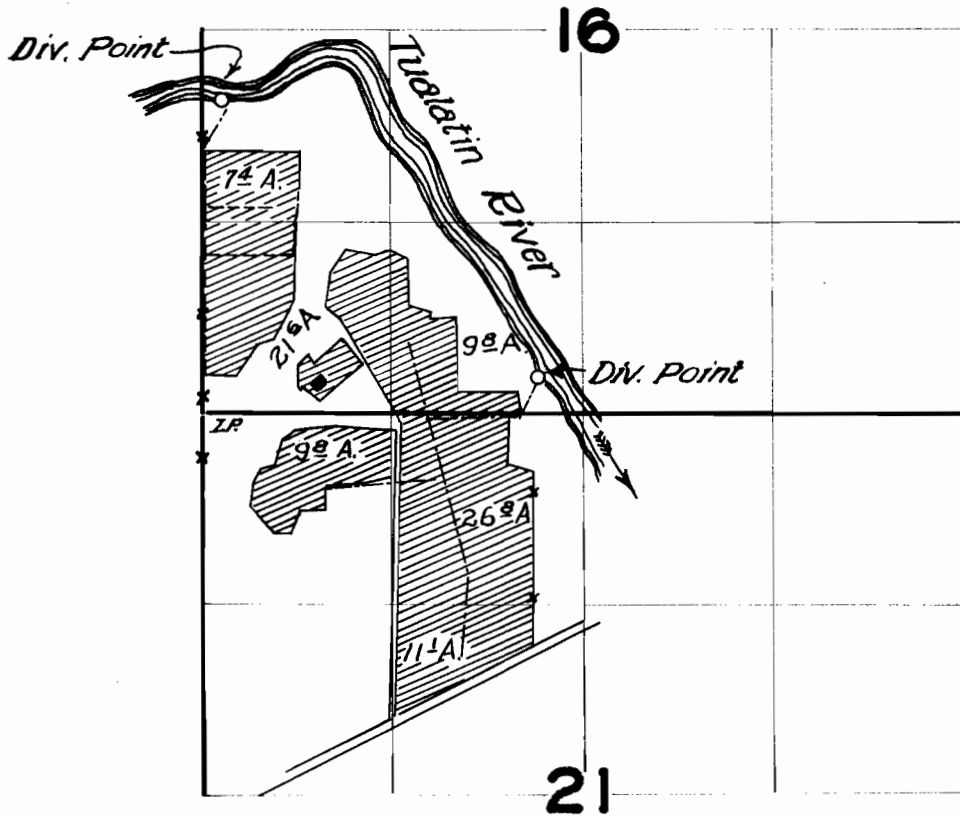

FINAL PROOF SURVEY UNDER

Application No. 18312... Permit No. 14691...
IN NAME OF

RICHARD G. SCOTT

Surveyed MAY 10, 1951, by H.L. COFFMAN