


# T.2S.R.2W.W.M.

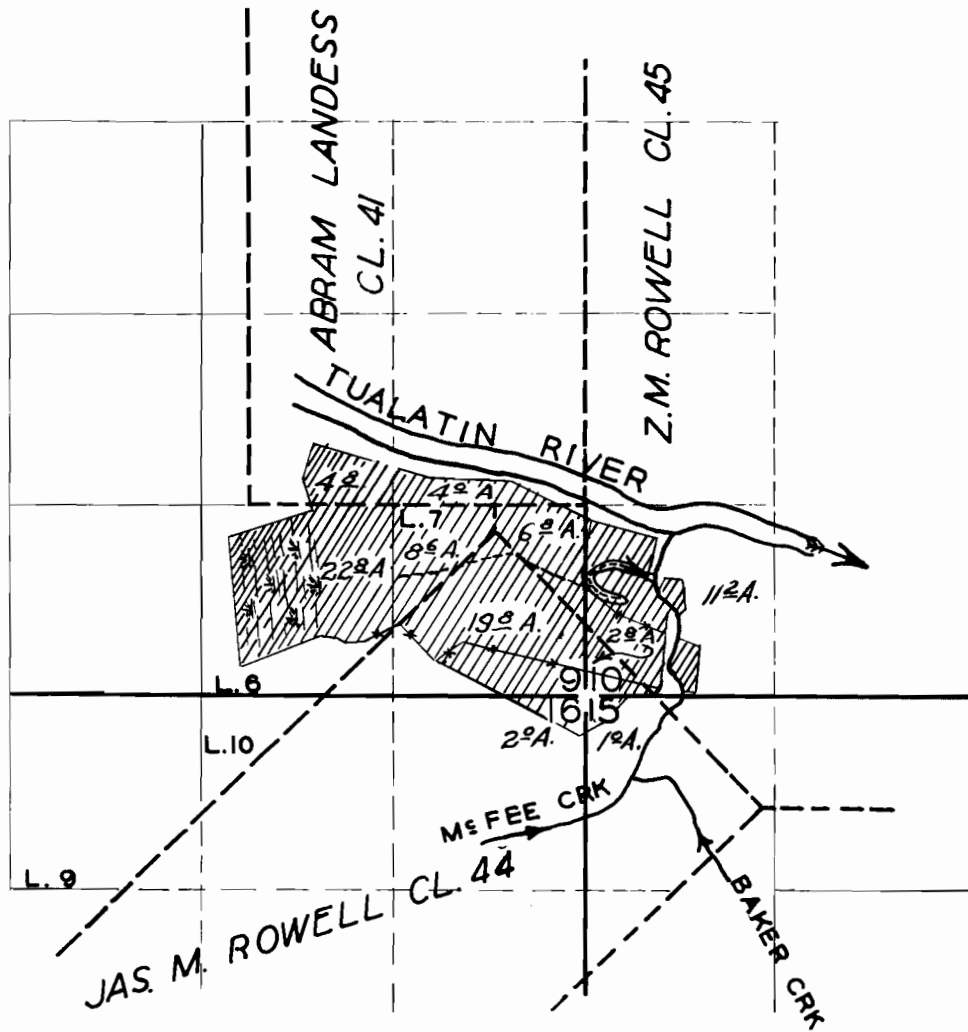

## FINAL PROOF SURVEY UNDER

Application No. 19147 Permit No. 14744  
IN NAME OF

LAND SYNDICATE LTD.

Surveyed MAY 29 1951, by H.L. COFFMAN