


T.2S.R.2W.W.M.

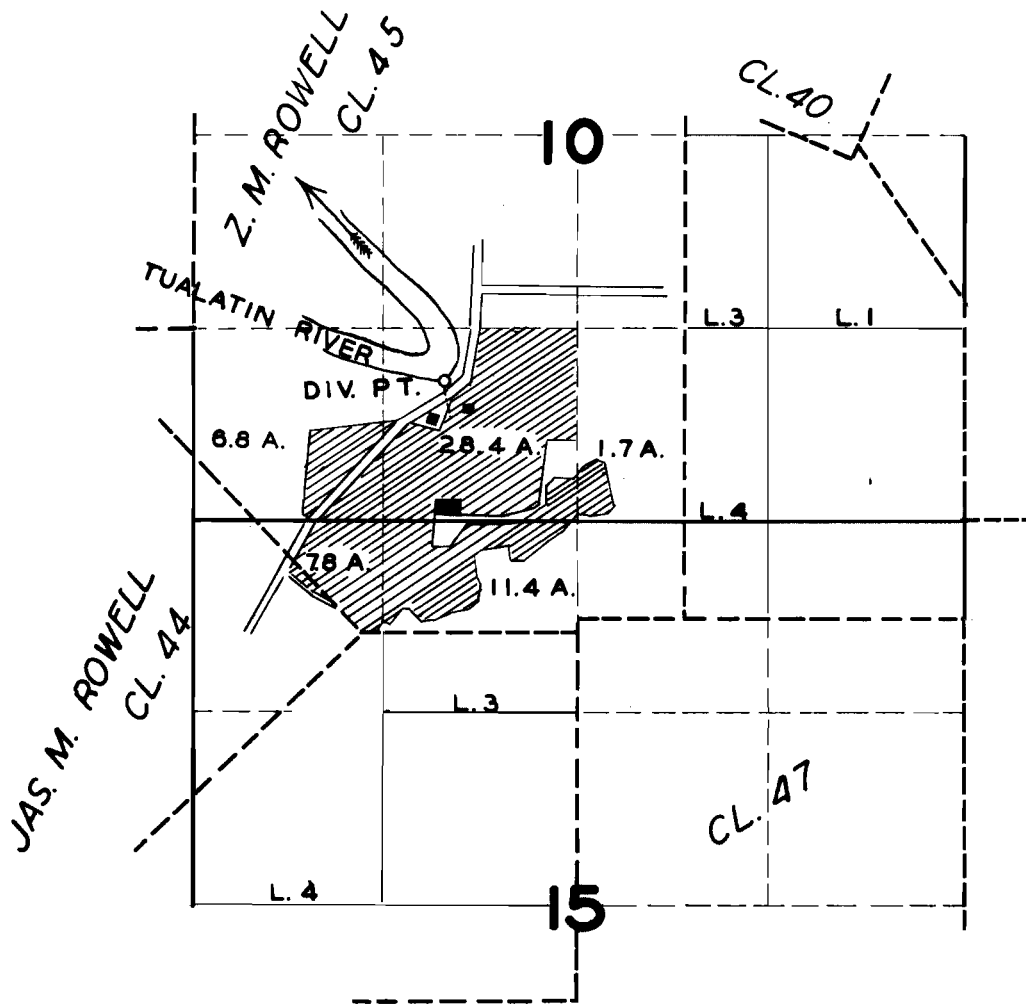

FINAL PROOF SURVEY

UNDER

Application No. 19198... Permit No. 14794...

IN NAME OF

..... F. E. & J. A. ROWELL

Surveyed MAY. 31. 1951., by H. L. COFFMAN