


T.16S.R.5W.W.M.

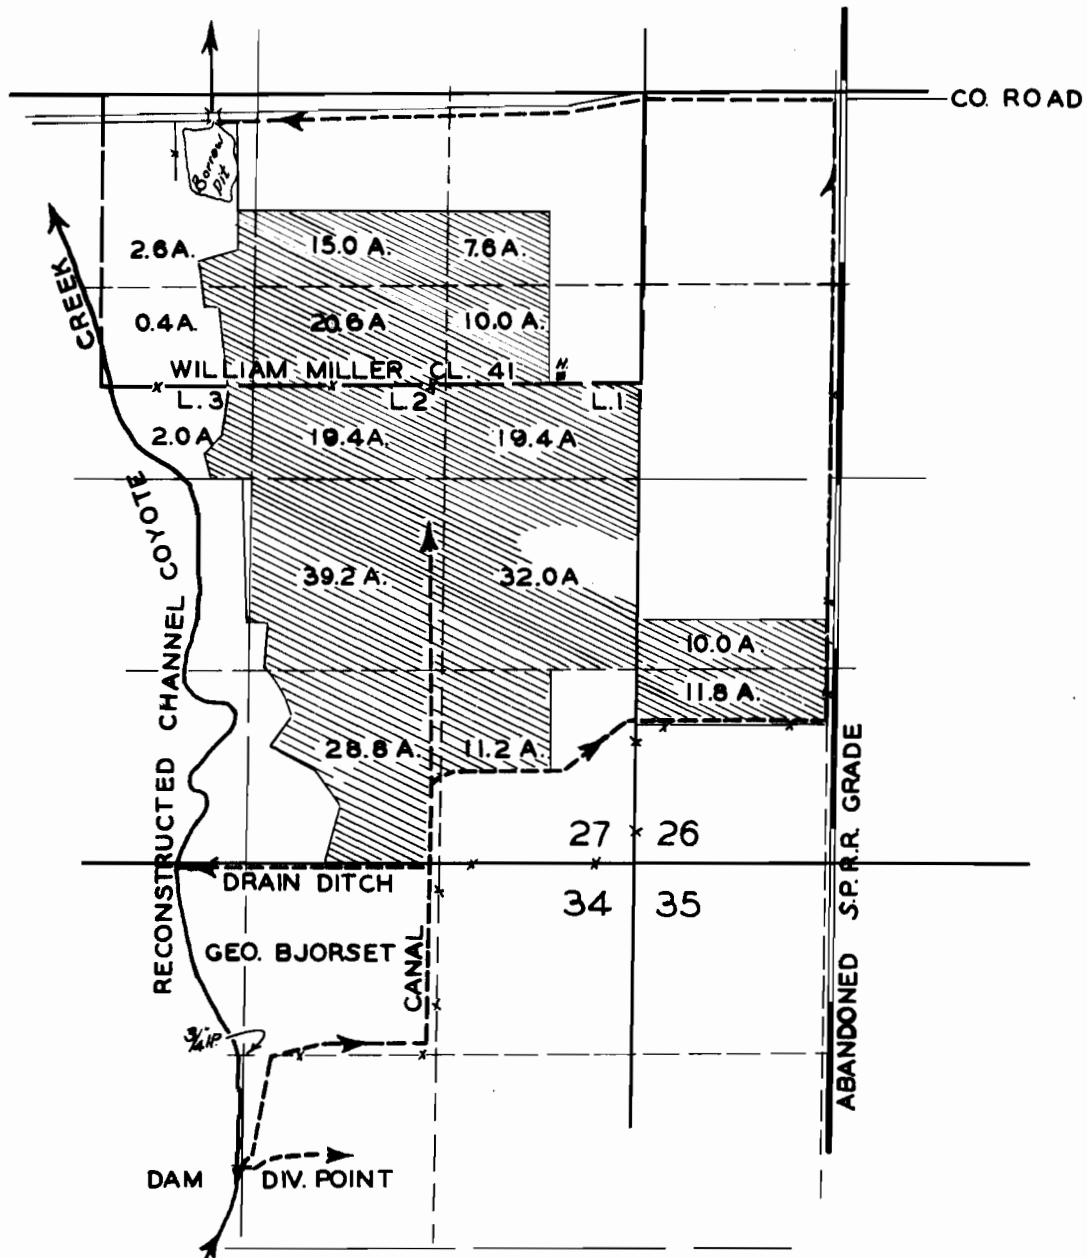

FINAL PROOF SURVEY

UNDER

Application No. 19410. Permit No. 14970.
IN NAME OF

ASH BAILEY

Surveyed MAY 26 1950, by H.L. COFFMAN