


T.3 S.R.1 W.W.M.

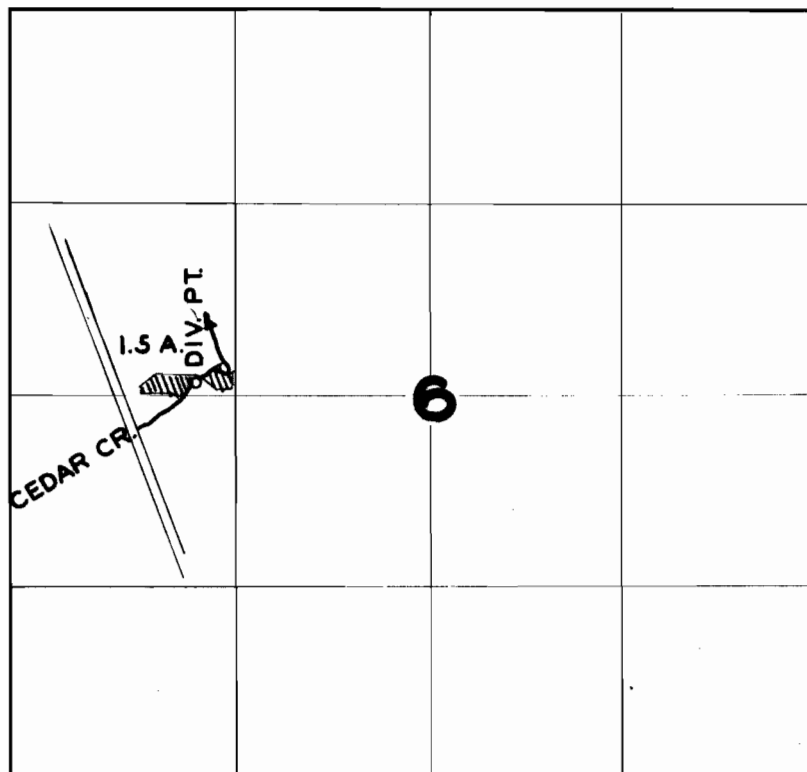

FINAL PROOF SURVEY
UNDER

Application No. 20488 Permit No. 15995
IN NAME OF

FREDERICK A. HULVERSON

Surveyed MAY 7 1951, by H.L. COFFMAN