


T.2S.R.3W.W.M.

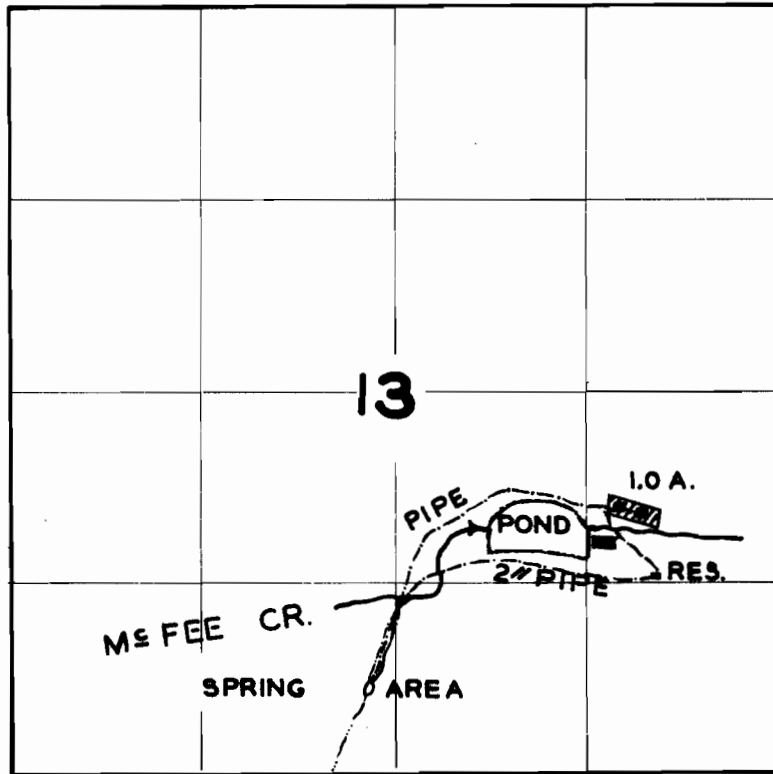

**FINAL PROOF SURVEY**  
UNDER

Application No. 20400... Permit No. 16681...  
IN NAME OF

..... OSCAR RAINES .....

Surveyed JUNE 7, 1951., by H.L. COFFMAN