


# T.5 S. R. 5 W.W.M.

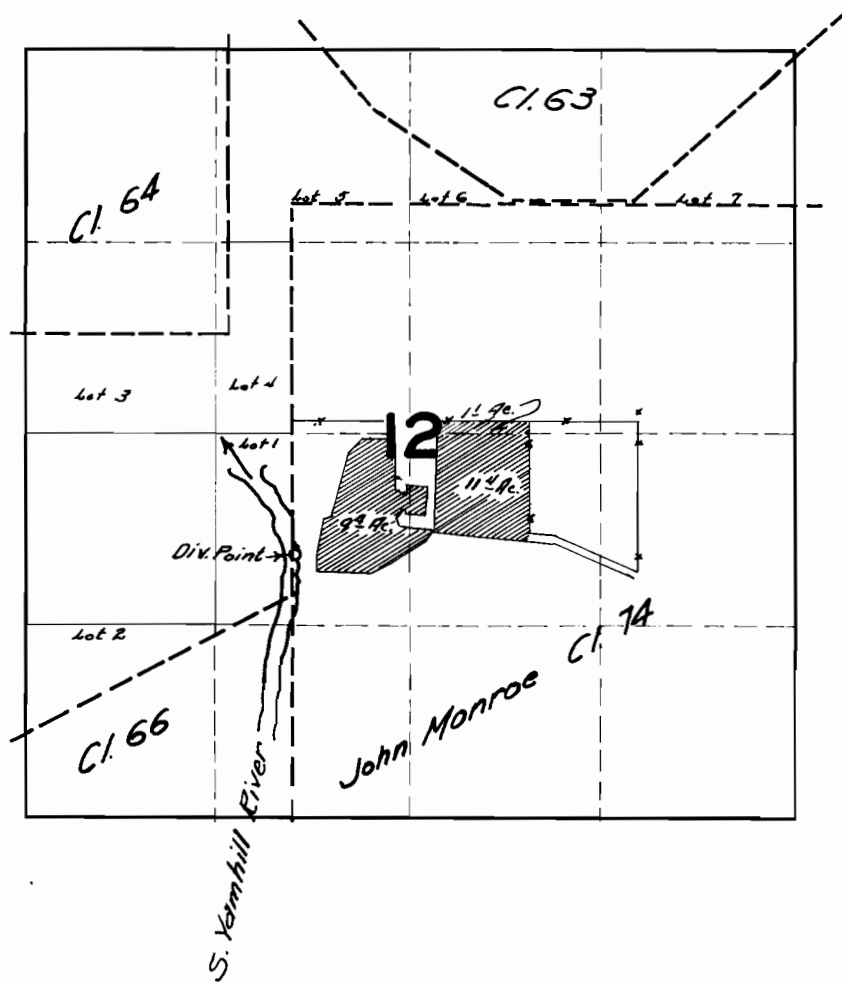

## FINAL PROOF SURVEY UNDER

Application No. 18232 Perm. No. 13893  
IN NAME OF

VAN K. LAWSON

Surveyed 9/13 1951, by H.L. COFFMAN