


T. 2S. R. 2W. W.M.

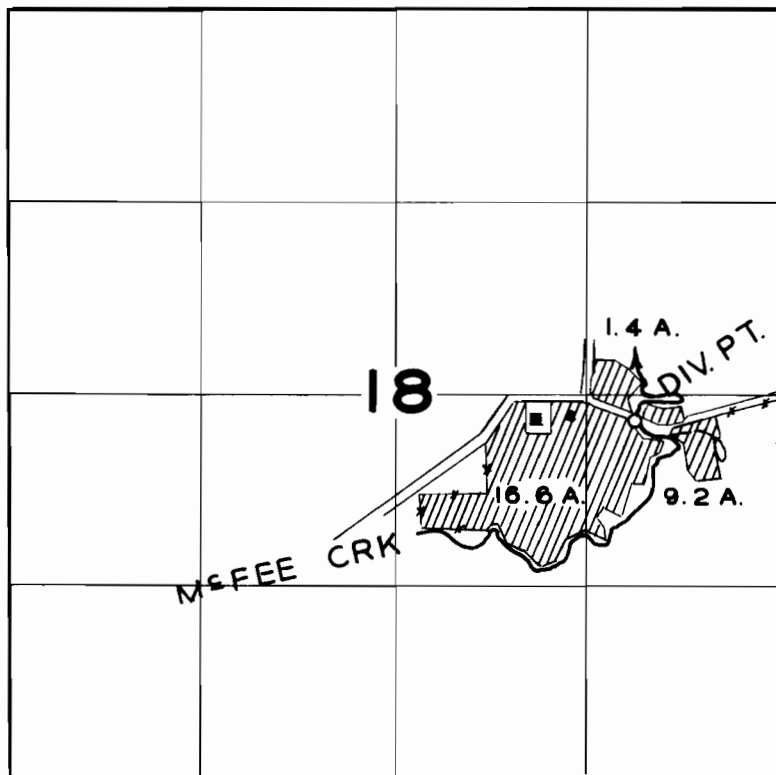

FINAL PROOF SURVEY

UNDER

Application No. 2050.6.. Permit No. 16008..

IN NAME OF

.....T. R. MOORE.....

Surveyed JUNE 6 1951., by H. L. COFFMAN