


T. I. S. R. 3 W. W. M.

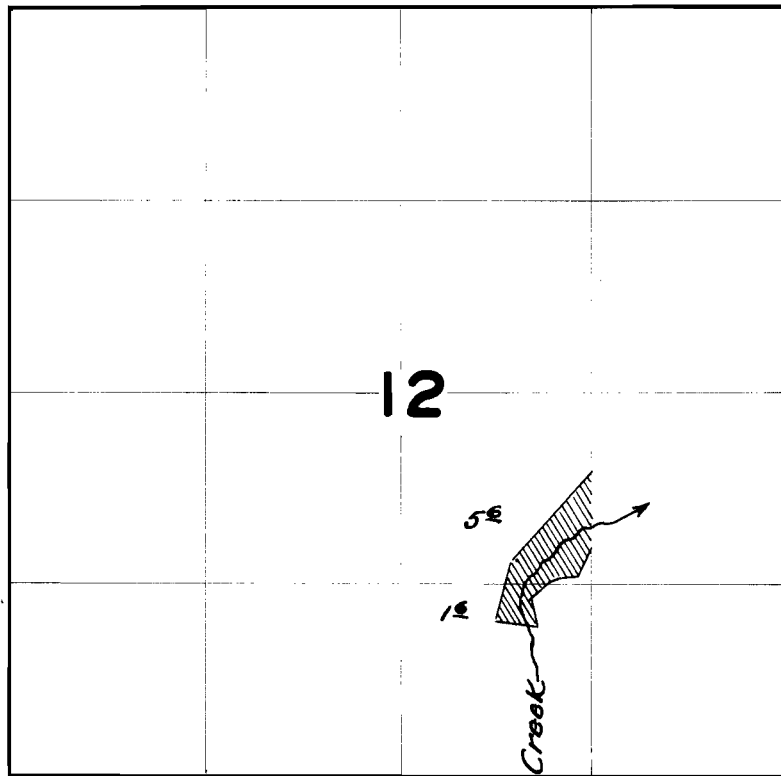

FINAL PROOF SURVEY UNDER

Application No. 20555 Permit No. 16047
IN NAME OF

H. W. & L. E. CURRIN

Surveyed 7/31 1951, by H. L. COFFMAN