
T.9S.R. I W. W.M.

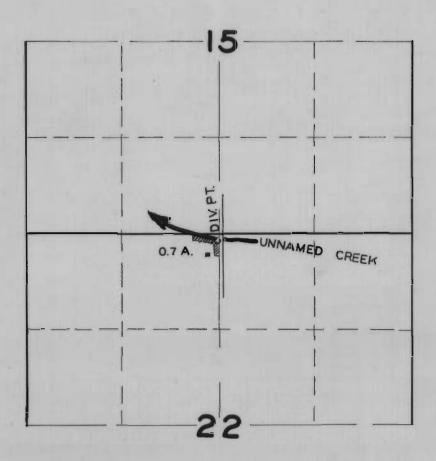

FINAL PROOF SURVEY

UNDER

Application No.20787 Permit No. 16267

C. H. FORSLUND

Surveyed APR 9 1951, by H.L. COFFMAN