


T.17S. R.6W. W.M.

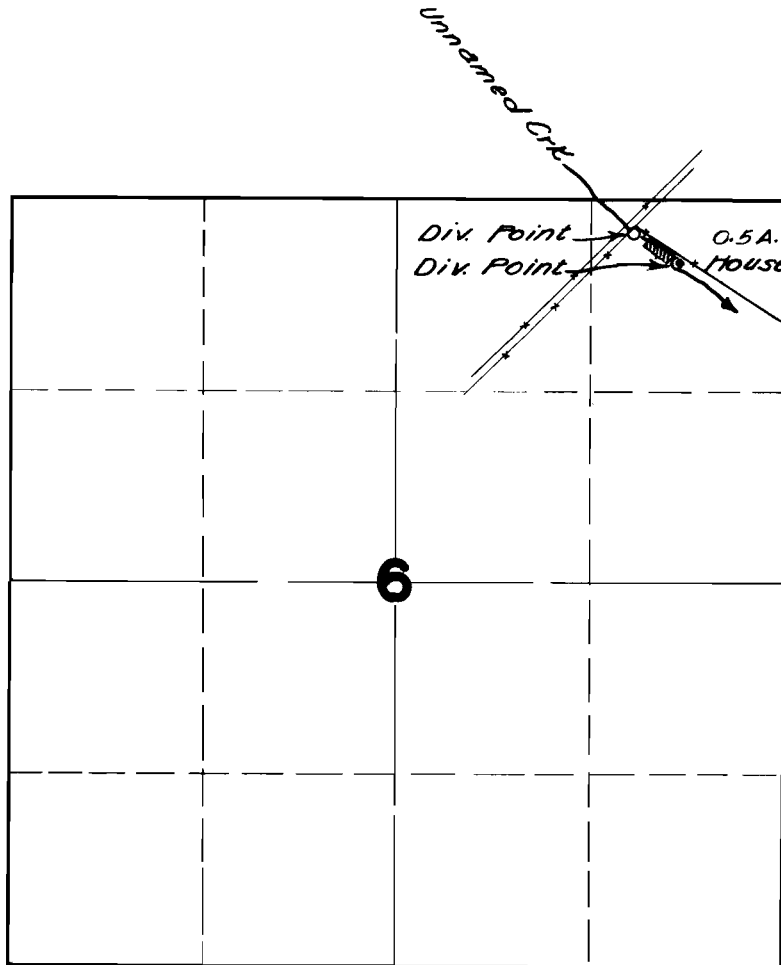

FINAL PROOF SURVEY
UNDER

Application No. 21610..... Permit No. 16979.....
IN NAME OF

.....MRS. DIXIE I. SMITH.....

Surveyed MAY 11, 1950, by H.L. COFFMAN