


T.19S.R.3 W.WM.

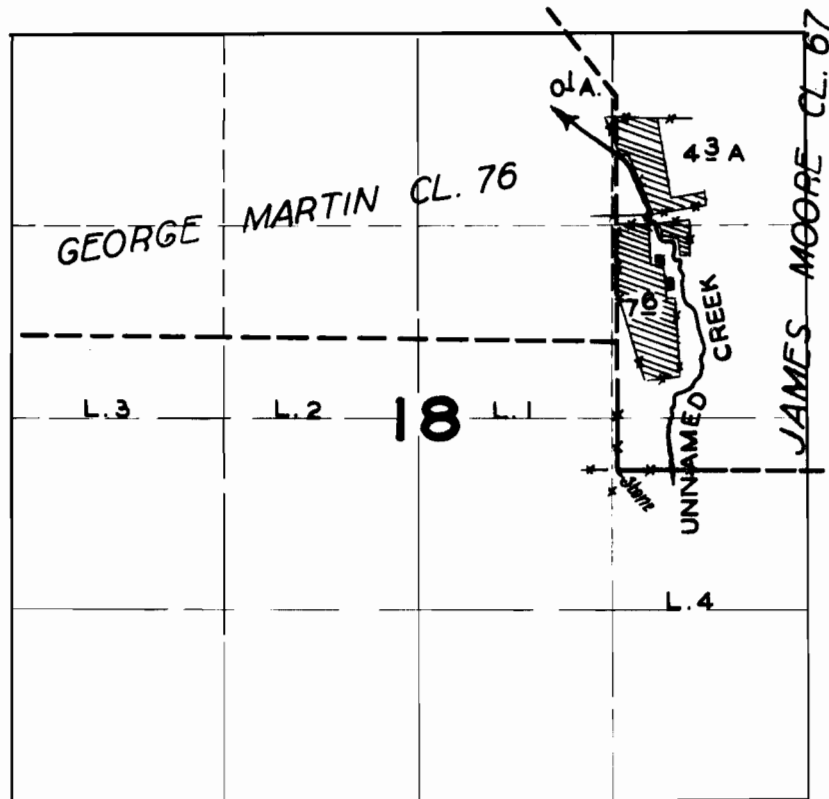

FINAL PROOF SURVEY
UNDER

Application No. 21645.. Permit No. 17080..
IN NAME OF

..... EDWARD H. NAPPER

Surveyed MAY 3... 1951... by H.L. COFFMAN