


T. I. S. R. | W. W. M.

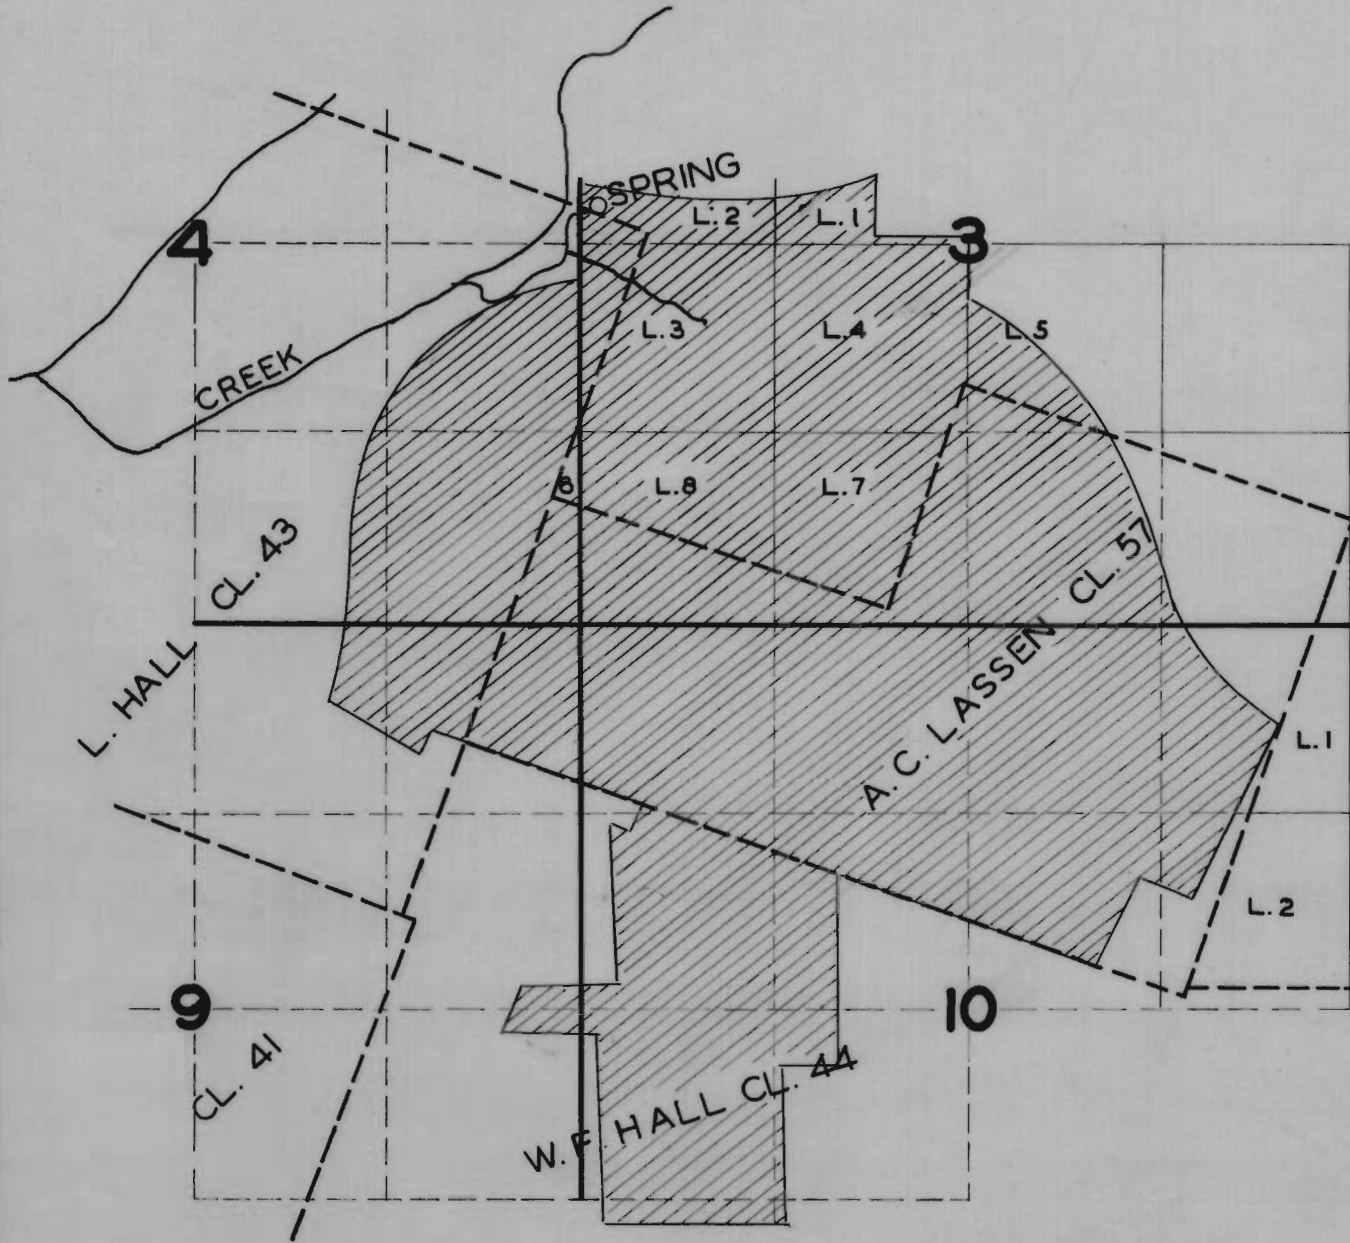

FINAL PROOF SURVEY

UNDER

Application No. 20889. Permit No. 16795.

IN NAME OF

..... CEDAR HILLS CO.

Surveyed 6/28 1951, by H. L. COFFMAN