


T. I. S. R. 2 W. W. M.

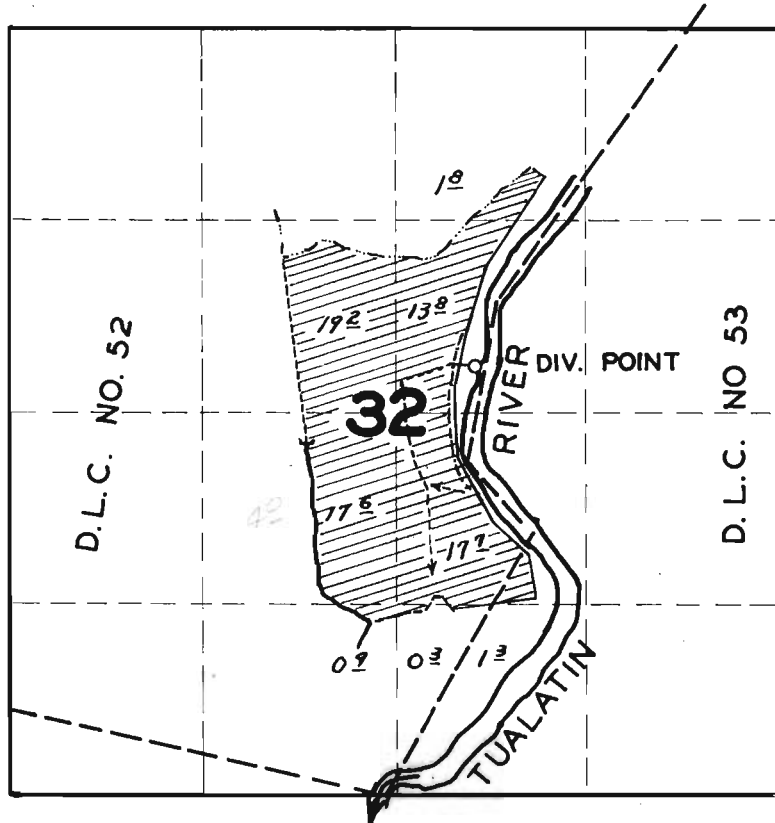

FINAL PROOF SURVEY

UNDER

Application No. ~~14150~~⁵¹⁰ Permit No. 10513

IN NAME OF

W. T. PUTNAM & SONS

Surveyed 7/3 1951, by H.L. COFFMAN