


T.7S.R.38E.W.M.

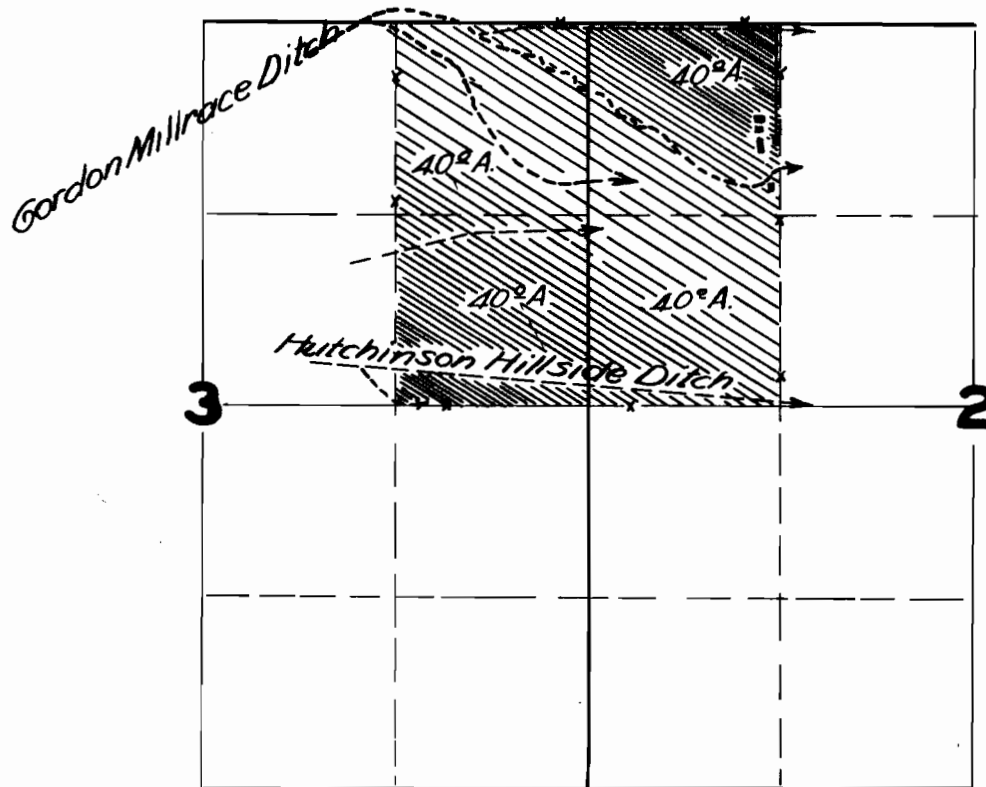

FINAL PROOF SURVEY

UNDER

Application No. 21947... Permit No. 7268...

IN NAME OF

A. W. & ROSE PETERS

Surveyed OCT. 21, 1950, by H. L. COFFMAN.