


T.13S.R.3W.W.M.

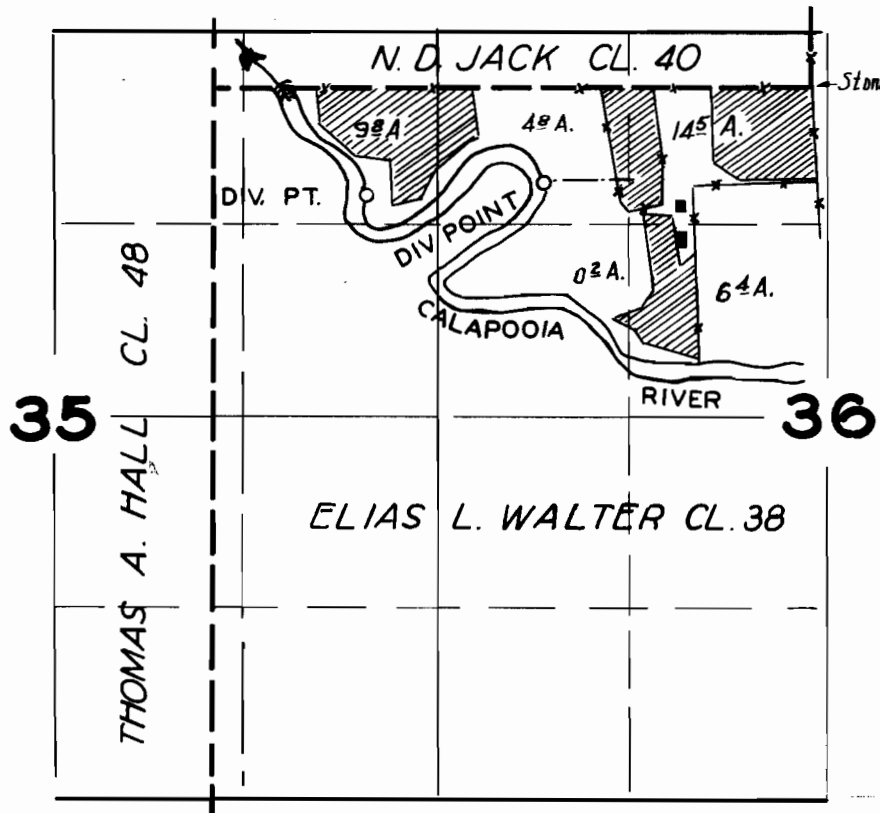

FINAL PROOF SURVEY UNDER

Application No. 21790... Permit No. 17143...
IN NAME OF

.....RAY J. CUNNINGHAM.....

Surveyed APR. 24. 1951., by H.L. COFFMAN..