


T.2S. R.1W.W.M.

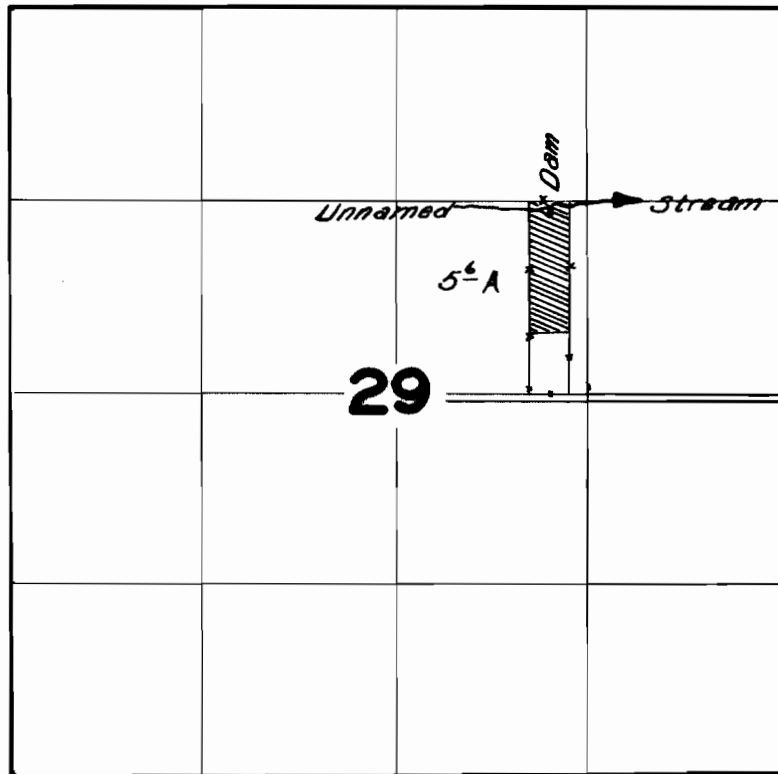

FINAL PROOF SURVEY
UNDER

Application No. 21592 Permit No. 17388
IN NAME OF

FRANK STEYAERT

Surveyed MAY 7, 1951, by H.L. COFFMAN