


T.18S. R.1 W.W.M.

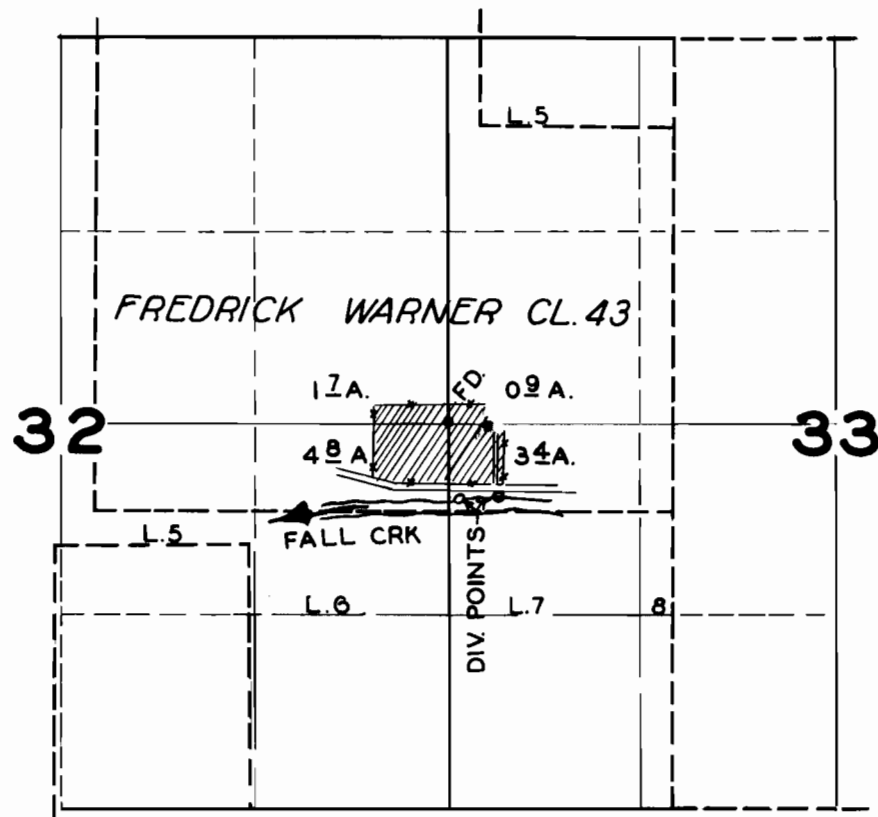

FINAL PROOF SURVEY
UNDER

Application No. 22050. Permit No. 17362.
IN NAME OF

ALEX FRANCE

Surveyed MAY 2, 1951, by H.L. COFFMAN.