


T.29S. R.5W.W.M.

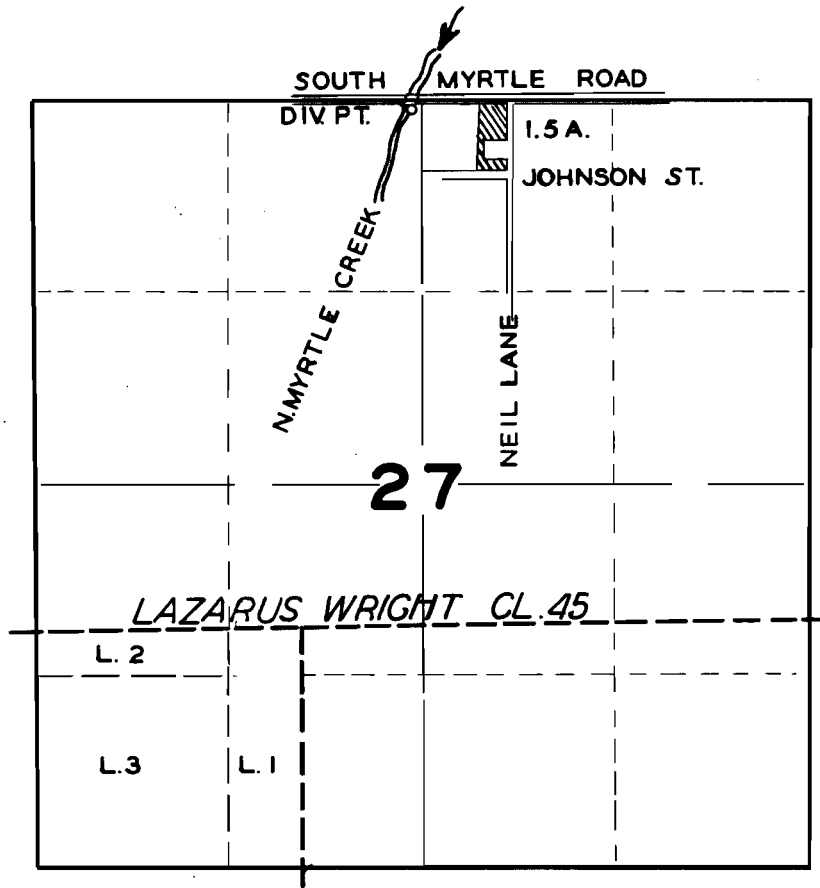

FINAL PROOF SURVEY
UNDER

Application No. **22292** Permit No. **17578**
IN NAME OF

C. C. HADLEY

Surveyed MAY 17, 1950, by H.L. COFFMAN