


T.2S.R.2W.W.M.

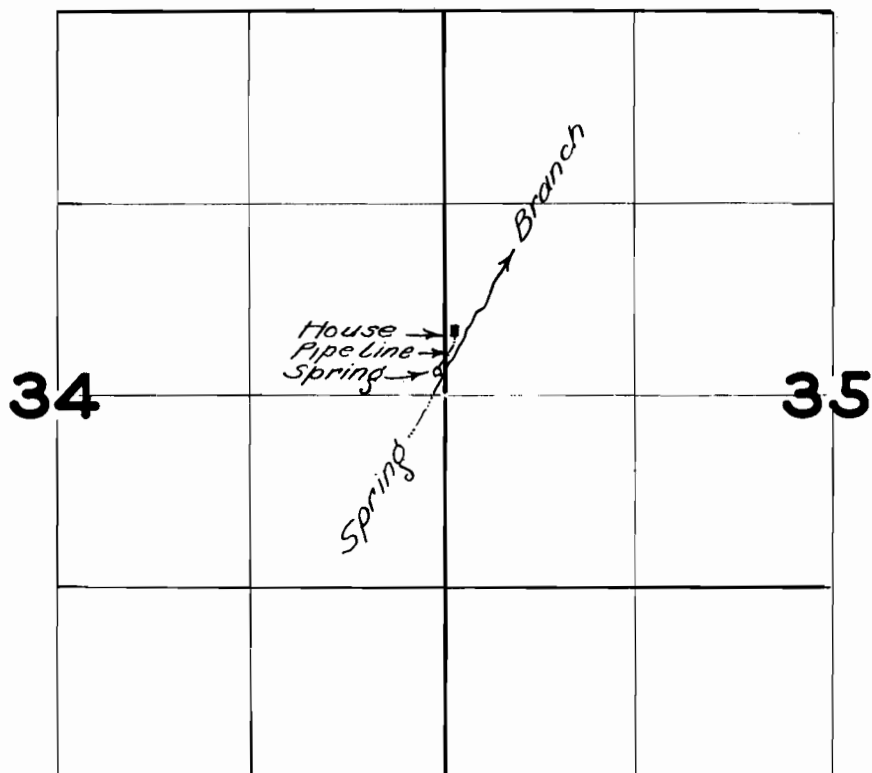

FINAL PROOF SURVEY
UNDER

Application No. **22651**... Permit No. **17884**...
IN NAME OF

GEORGE ALLISON

Surveyed **MAY 7, 1951**, by **H.L. COFFMAN**