


T.7S.R.39E.W.M.

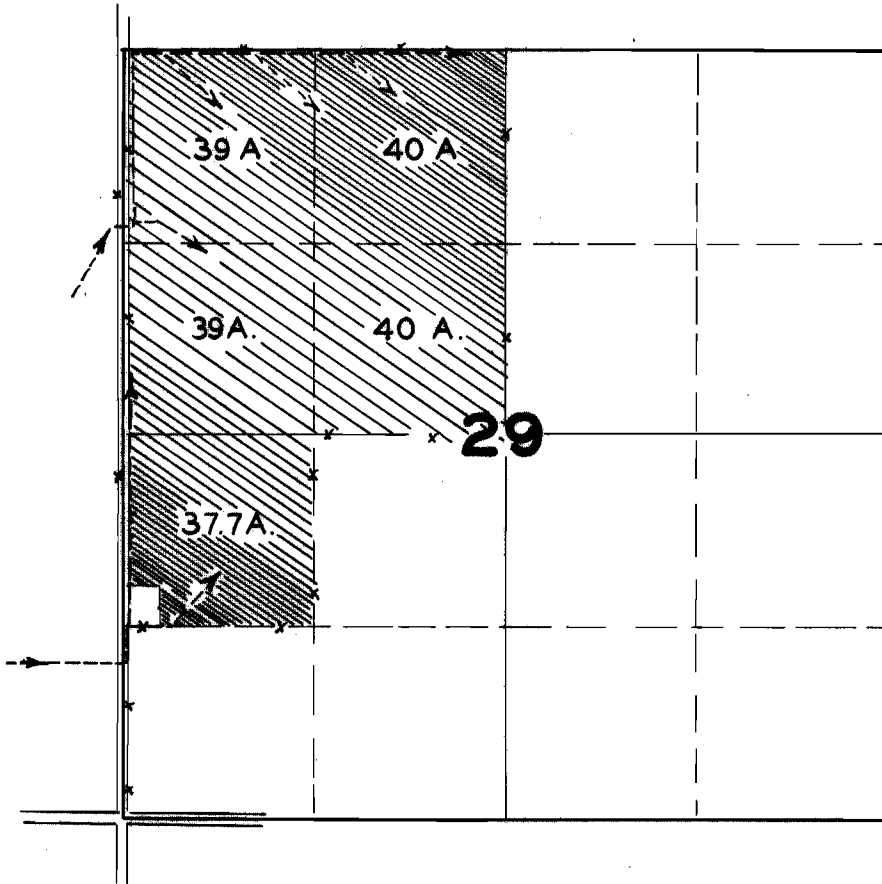

FINAL PROOF SURVEY UNDER

Application No. 22711... Permit No. 17891...
IN NAME OF

EDWARD W. & OLLIE COLES

Surveyed OCT. 20 1950, by H. L. COFFMAN