


T. I S. R. 2 W. W. M.

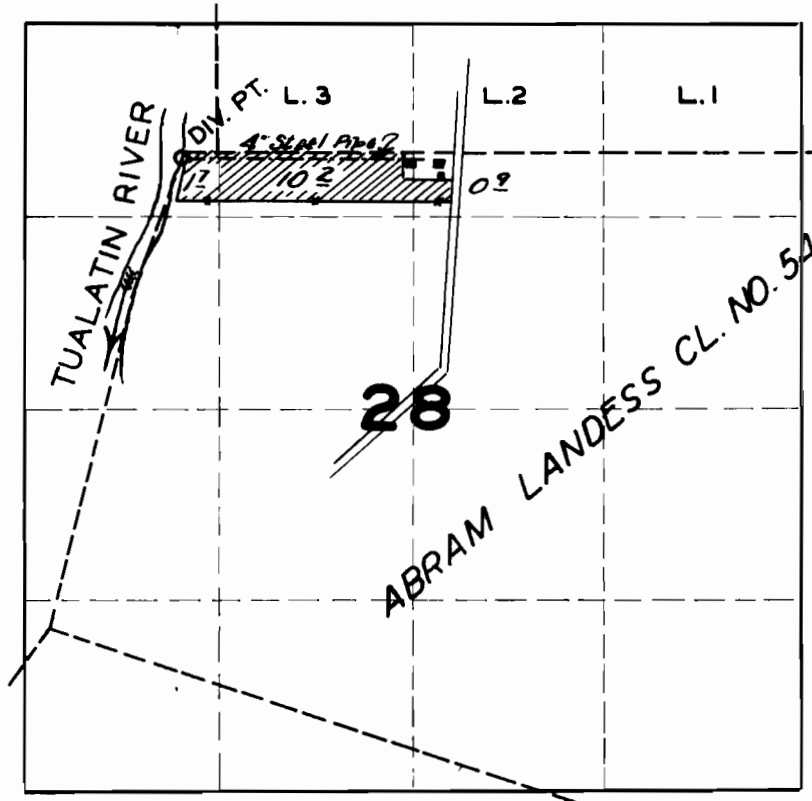

FINAL PROOF SURVEY

UNDER

Application No. 2.2.2.2.1 Permit No. 17495.

IN NAME OF

GUS KAUFMANN

Surveyed 7/10/1951, by H.L. COFFMAN.