


T. 1 S. R. 2 W. W. M.

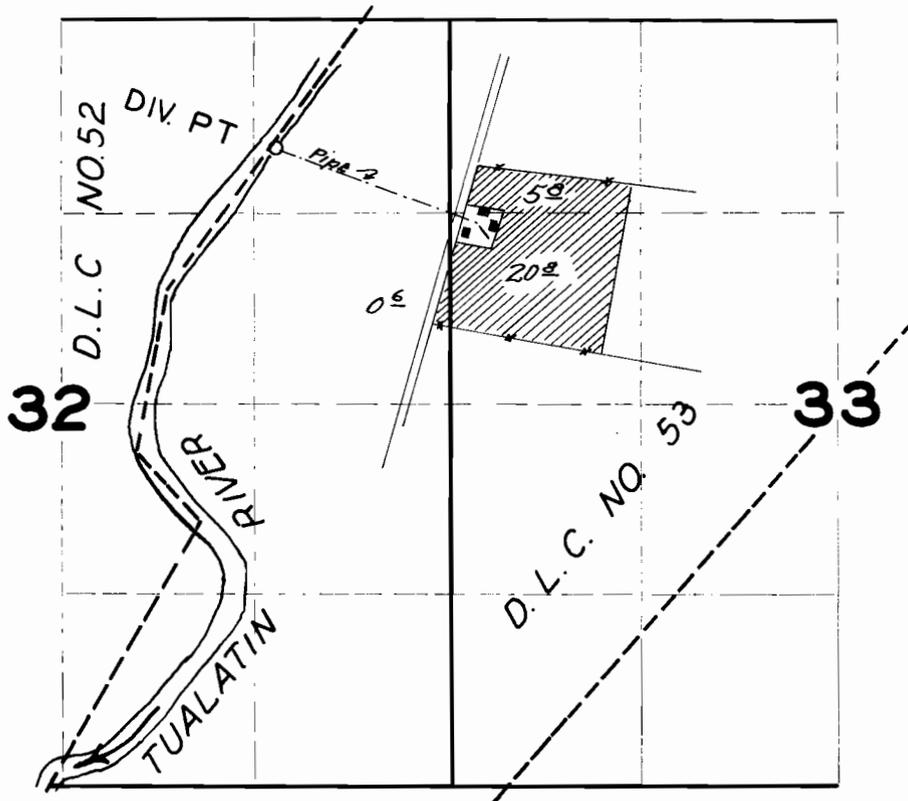

FINAL PROOF SURVEY UNDER

Application No. 22773... Permit No. 17939...
IN NAME OF

..... LLOYD BELLAMY

Surveyed 7/9..... 1951., by H.L. COFFMAN