


T.2S. R.2W. W.M.

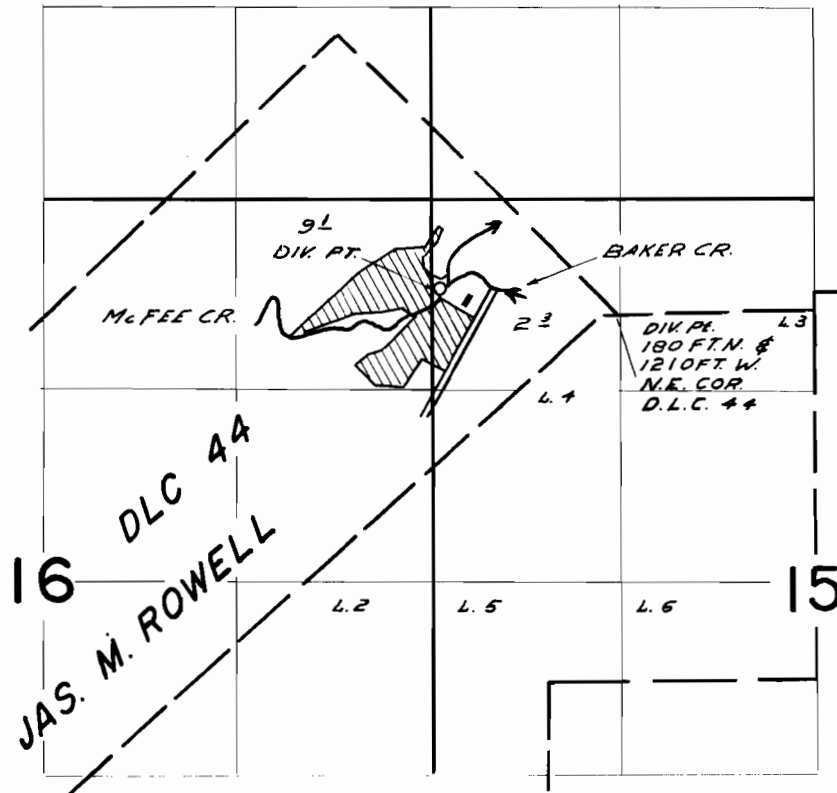


**FINAL PROOF SURVEY**  
UNDER

Application No. **19635** Permit No. **15227**  
IN NAME OF

**STANFORD A. GOTTER**

Surveyed **MAY 28 1951**, by **H. L. COFFMAN**

T.2S. R.2W.W.M.

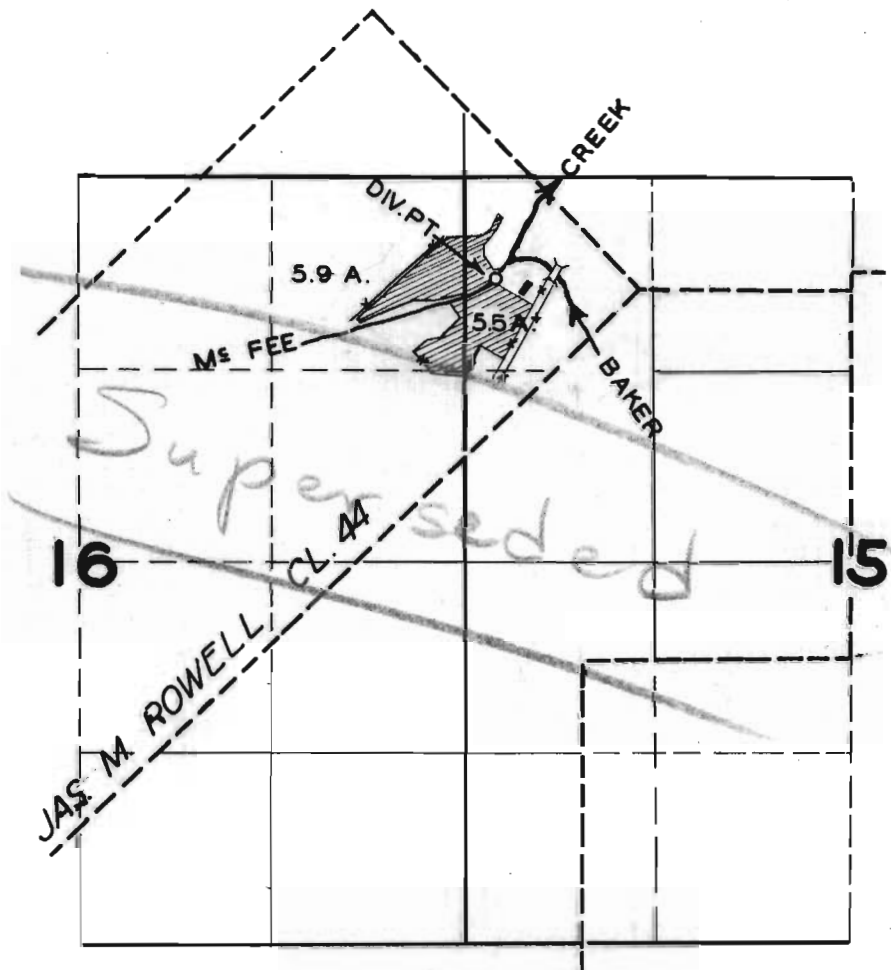

**FINAL PROOF SURVEY**  
UNDER

Application No. 196.35 Permit No. 152.27  
IN NAME OF

STANFORD A. GOTTER

Surveyed MAY 28 1951, by H.L. COFFMAN