


19167
19799

T34S. R7E.W.M.

Spring elev. 2 m. 0. c.

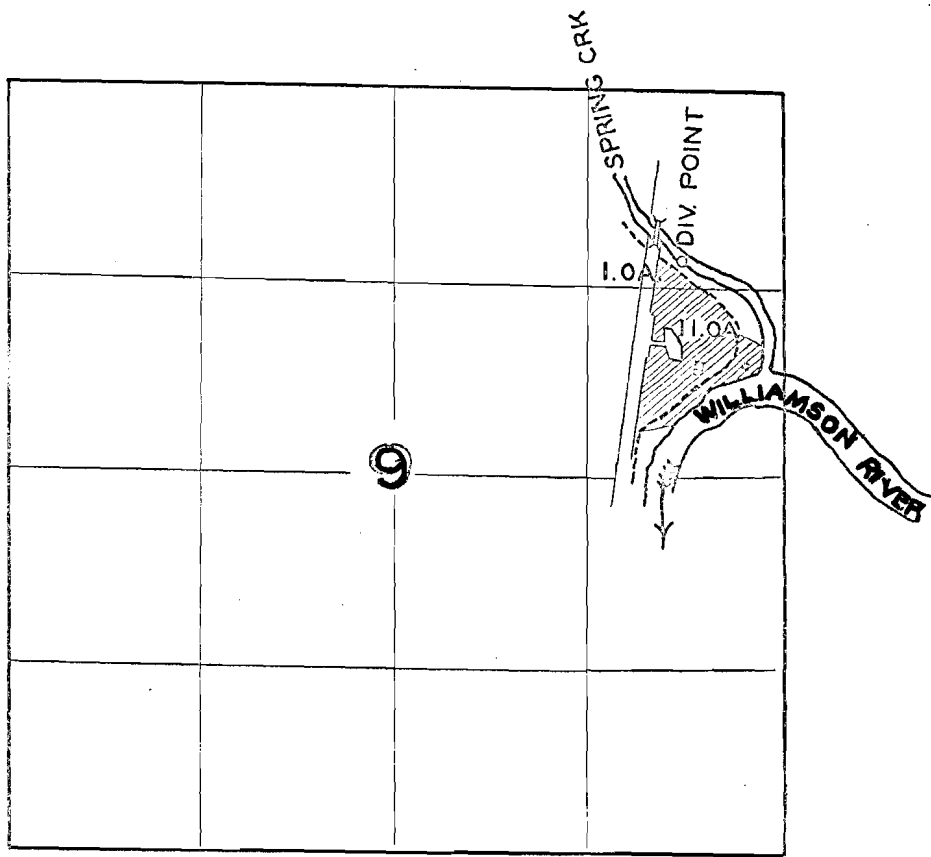

FINAL PROOF SURVEY UNDER

Application No. 22884 Permit No. 19167...
IN NAME OF

O. S. HWY. COMM. PARKS. DEPT.

Surveyed MAY. 24. 1951., by H.L. COFFMAN