





# Township 2 S.

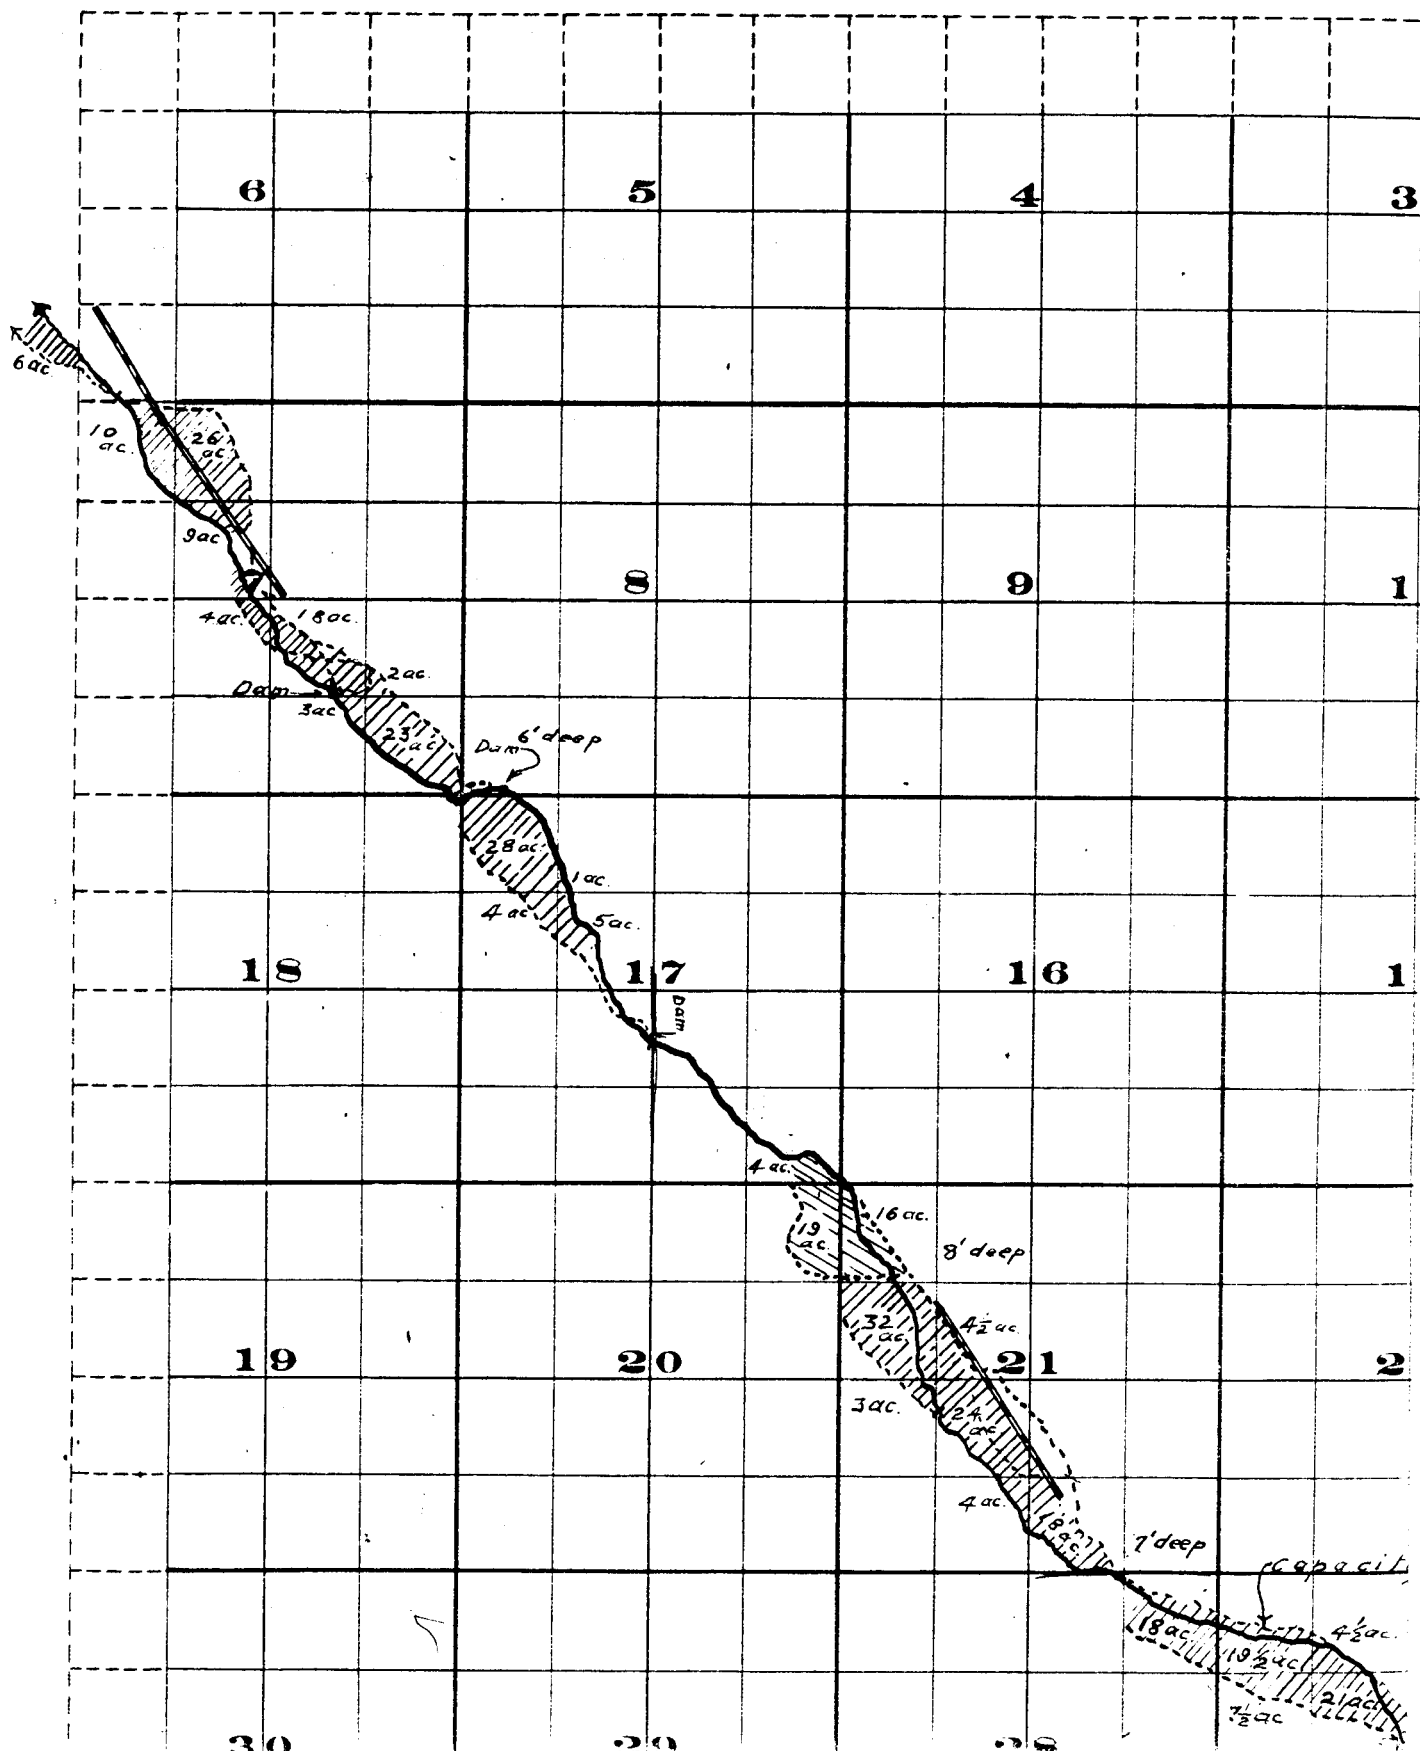

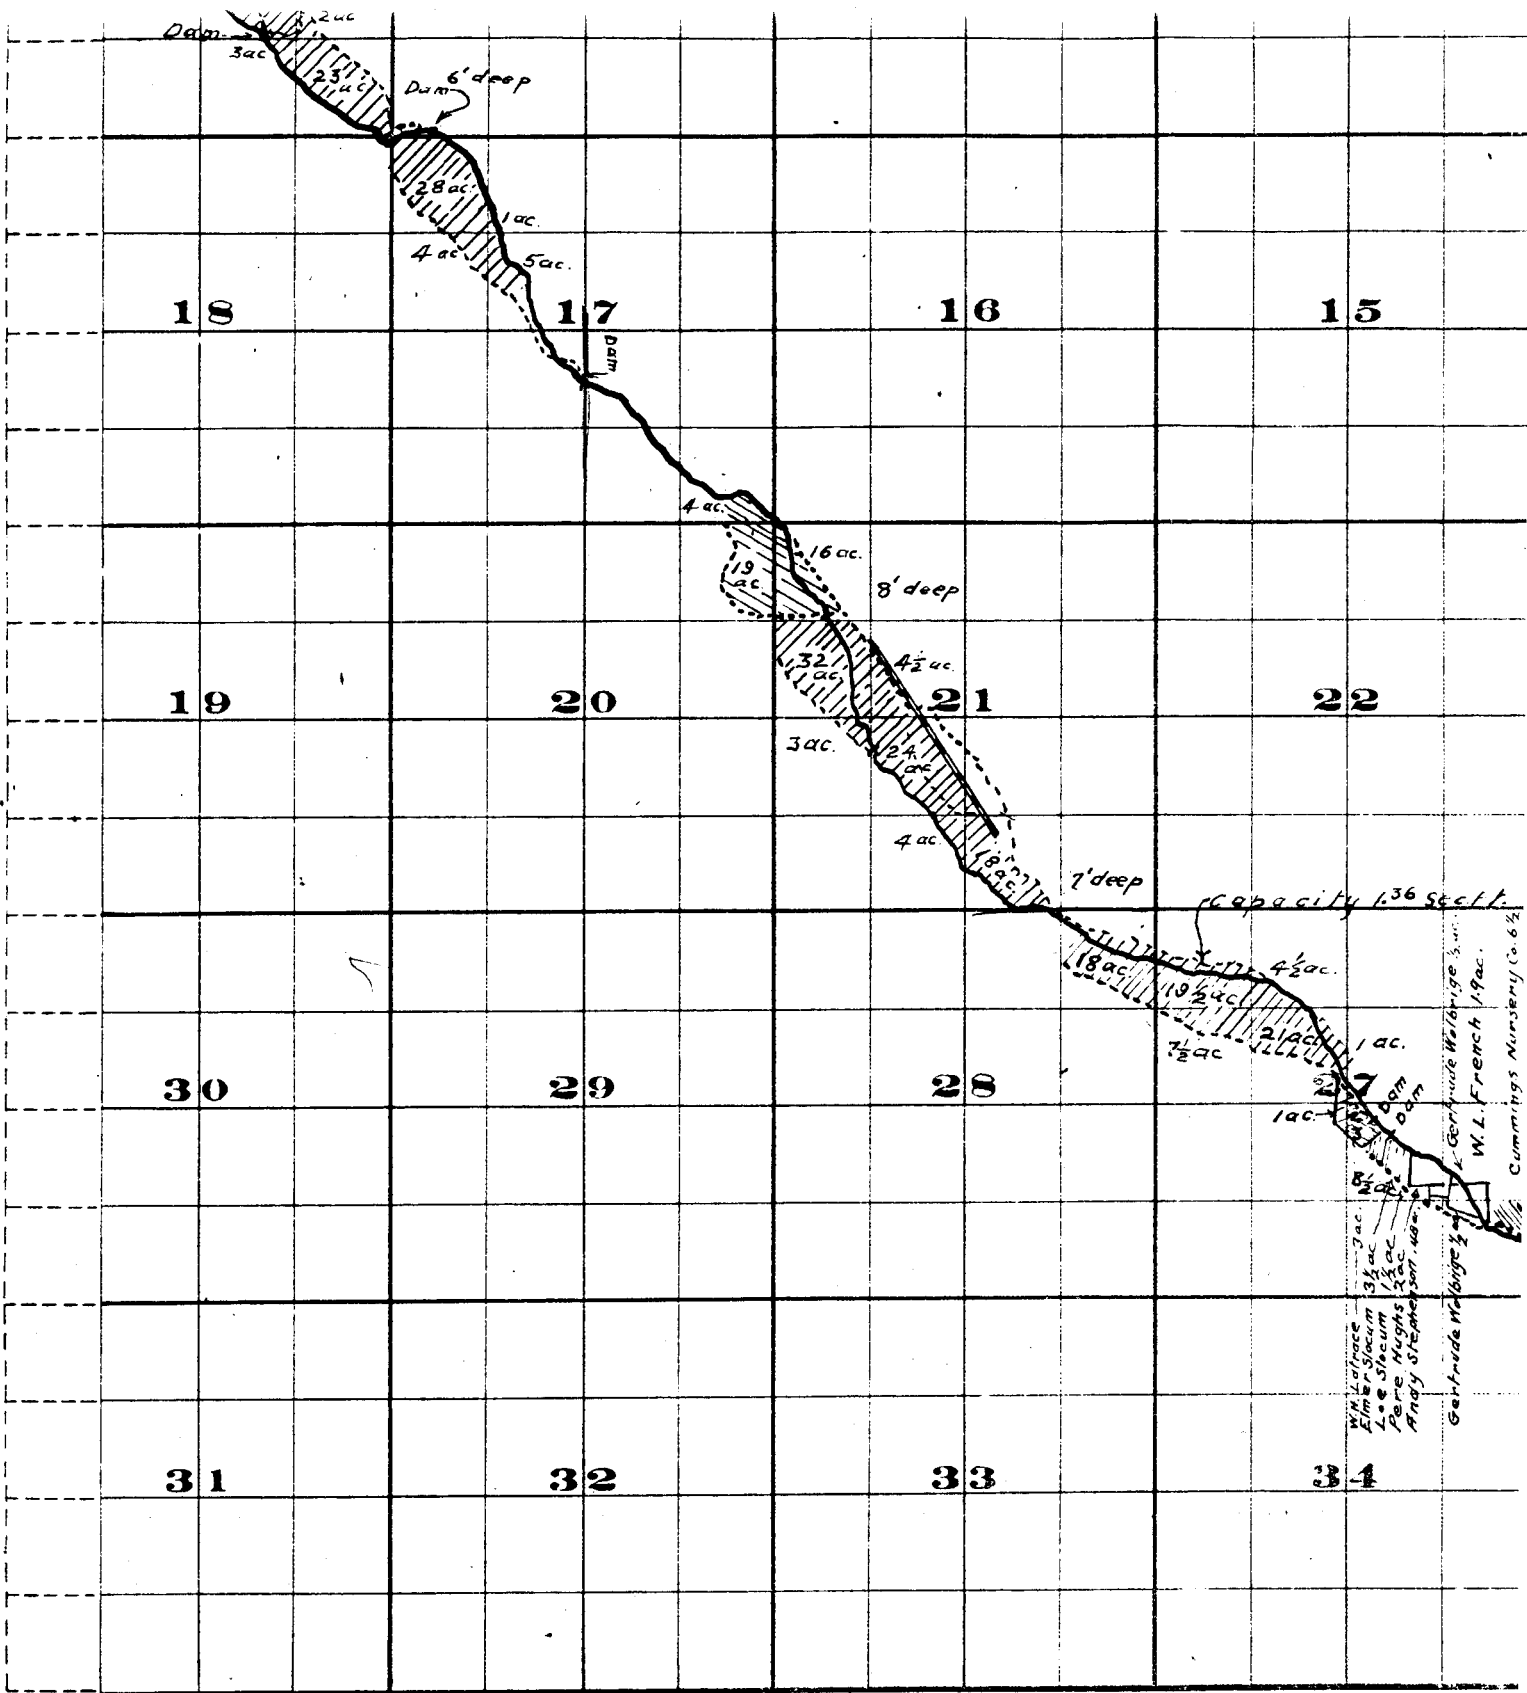


THE S. A. BRISTOL CO., PRINTERS & PUBLISHERS CHICAGO, ILL.

Surveyed by R.D. Cooper July 1909

John H. Lewis - State Engineer.

Examined July 14, 1909.



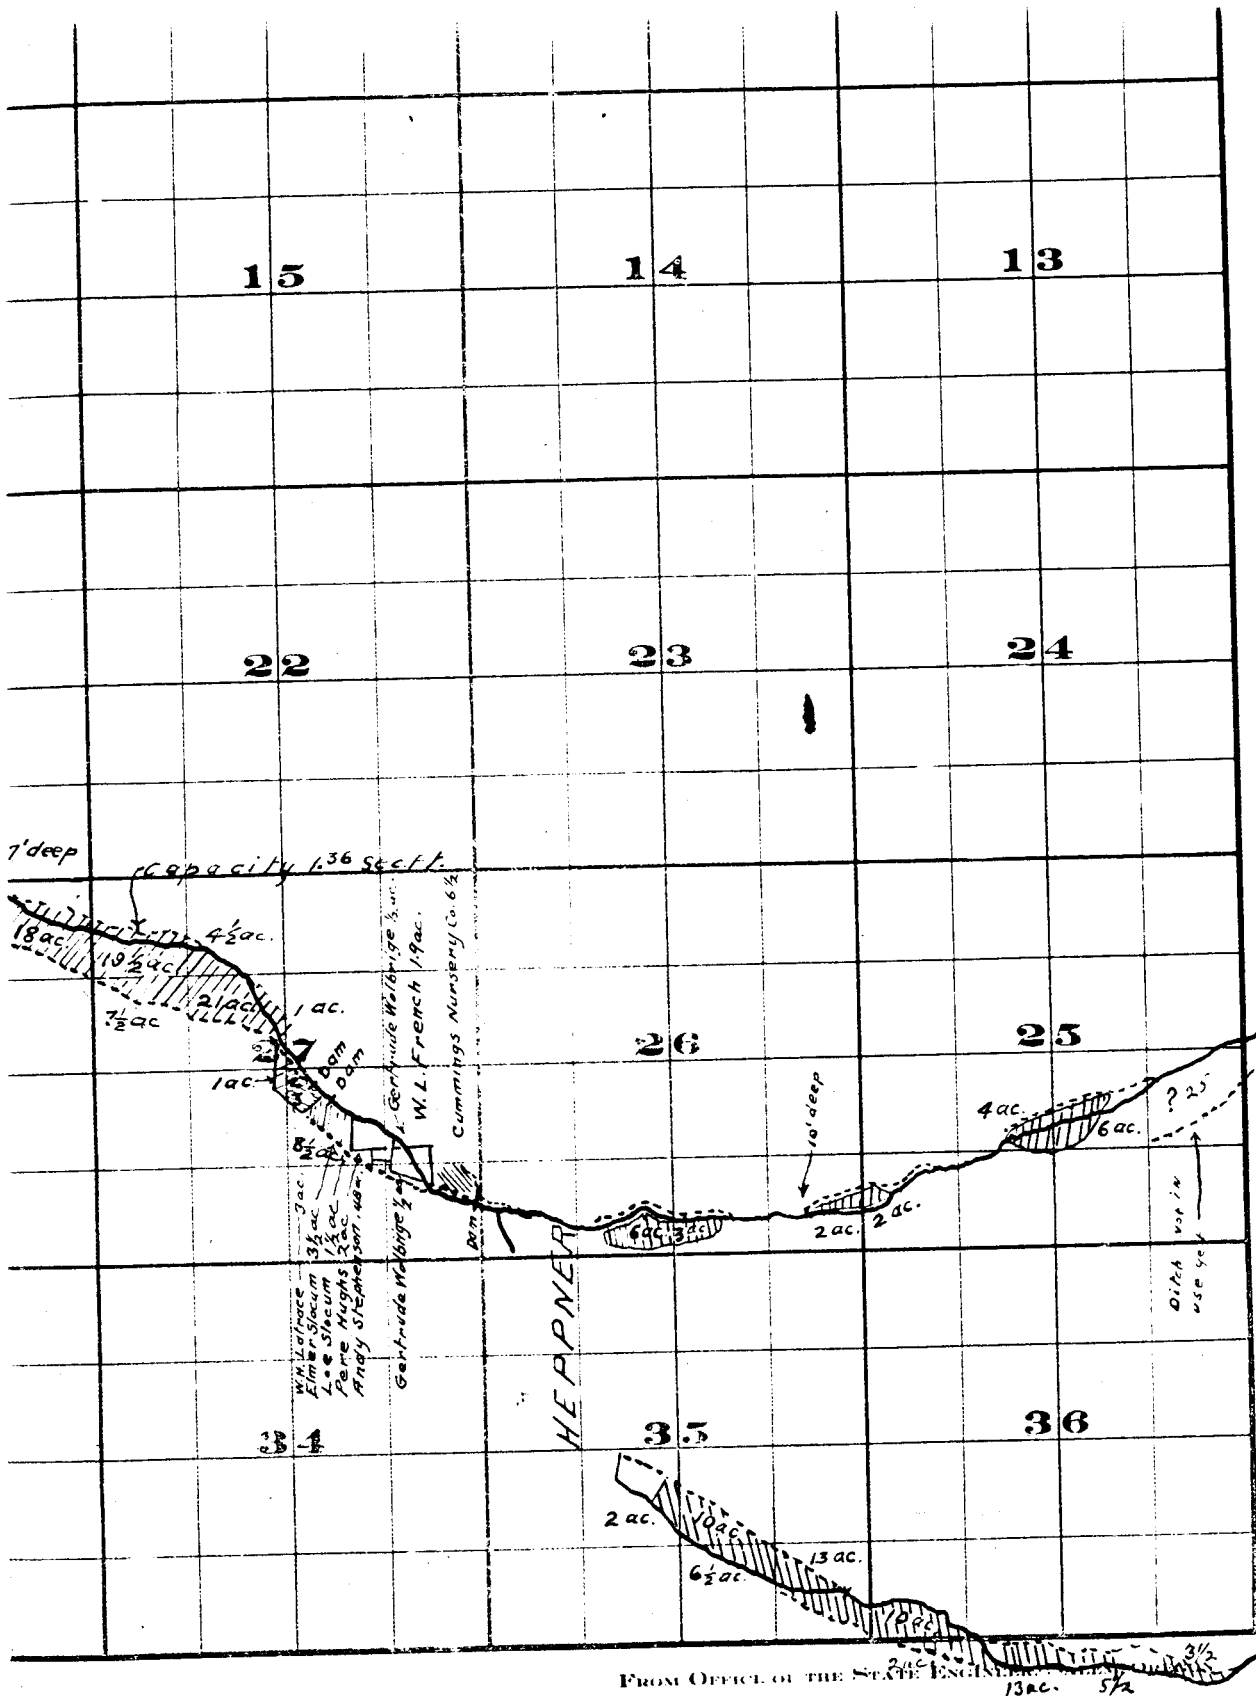

*Willow Creek Adjudication*

Part 3 S. 26  
2 S. 26