


21980

21779

21779

21779

T. 13S. R. 15E.

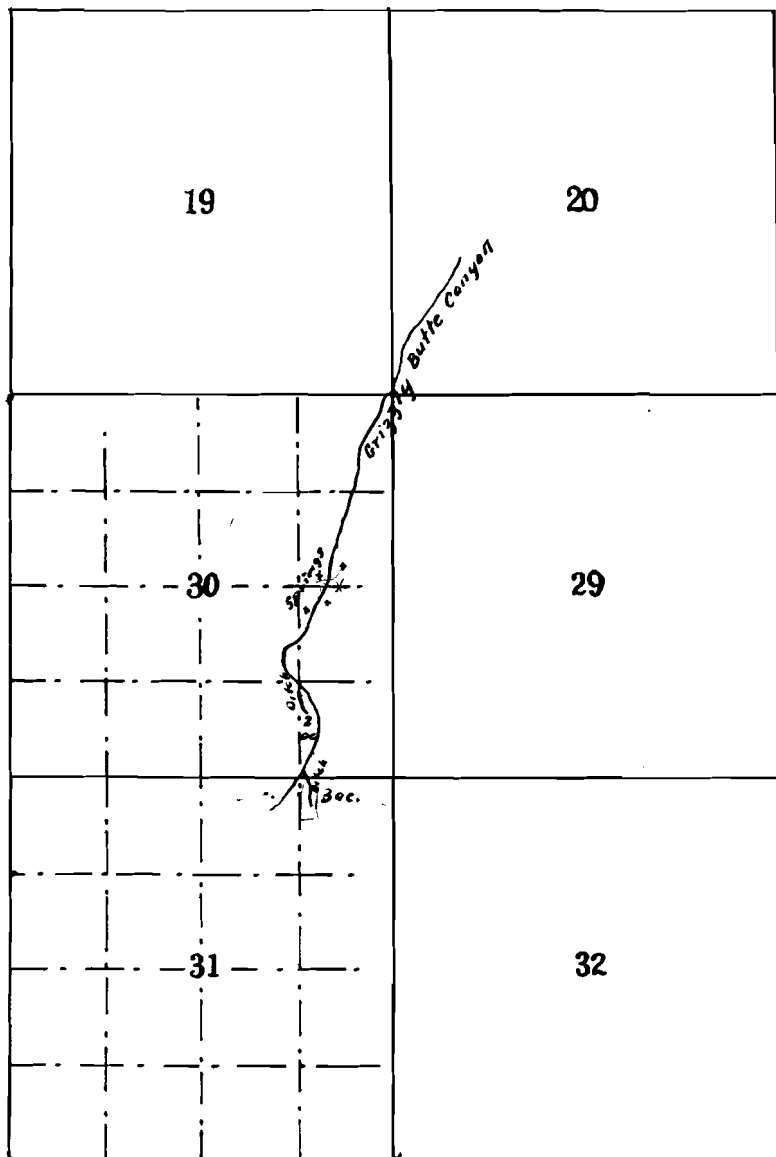

MAP OF
N. F. McCain Ditch
Crook County Oregon

Corrected map of Application No. 3816

RECORDED
SEP 11 1914
SALEM. OREGON.

Application No. 3816
Permit No. 2179