


T.21 S.R.46E.W.M.

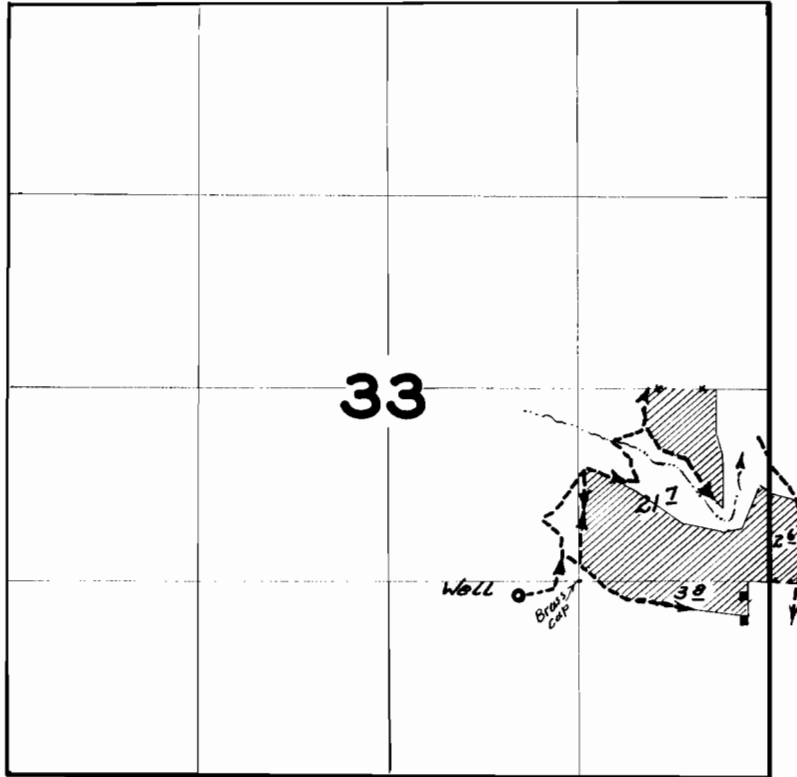

FINAL PROOF SURVEY

UNDER

Application No. U-180... Permit No. U-170.
IN NAME OF

JOHN K. CAMERON

Surveyed 8 / 24 1951, by H.L. COFFMAN