


# T.15 S.R.42 E.W.M.

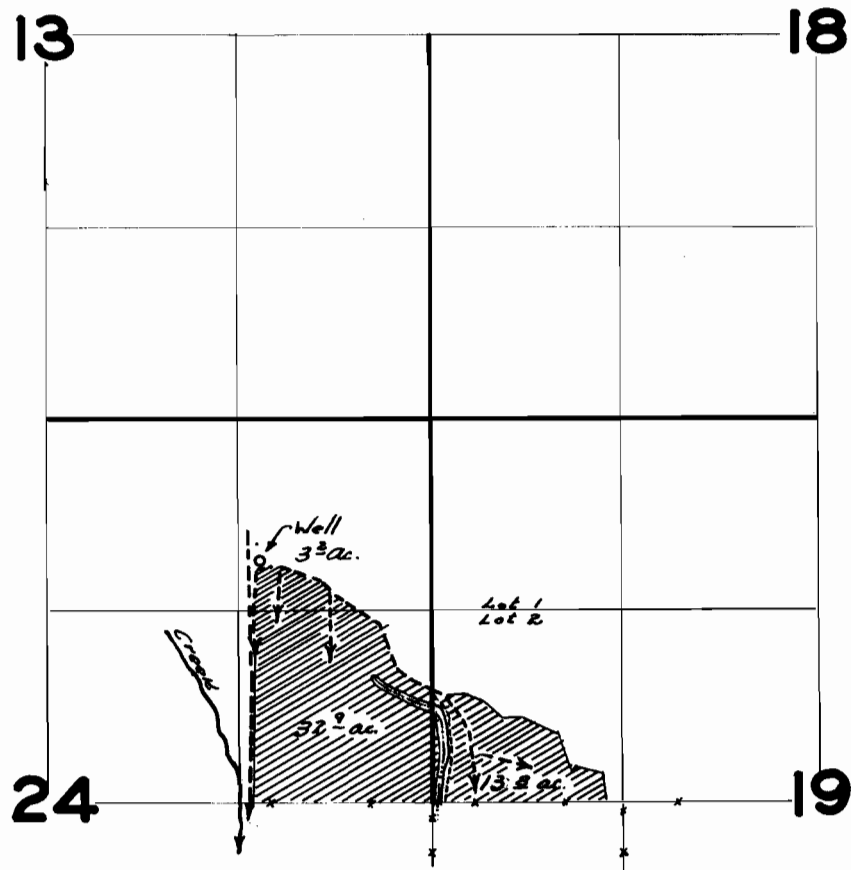

## FINAL PROOF SURVEY

UNDER

Application No. U-221. Permit No. U-201.  
IN NAME OF

DAVE P. LOGAN

Surveyed 8/28 1951, by H.L. COFFMAN.