


T.15S.R.43E.W.M.

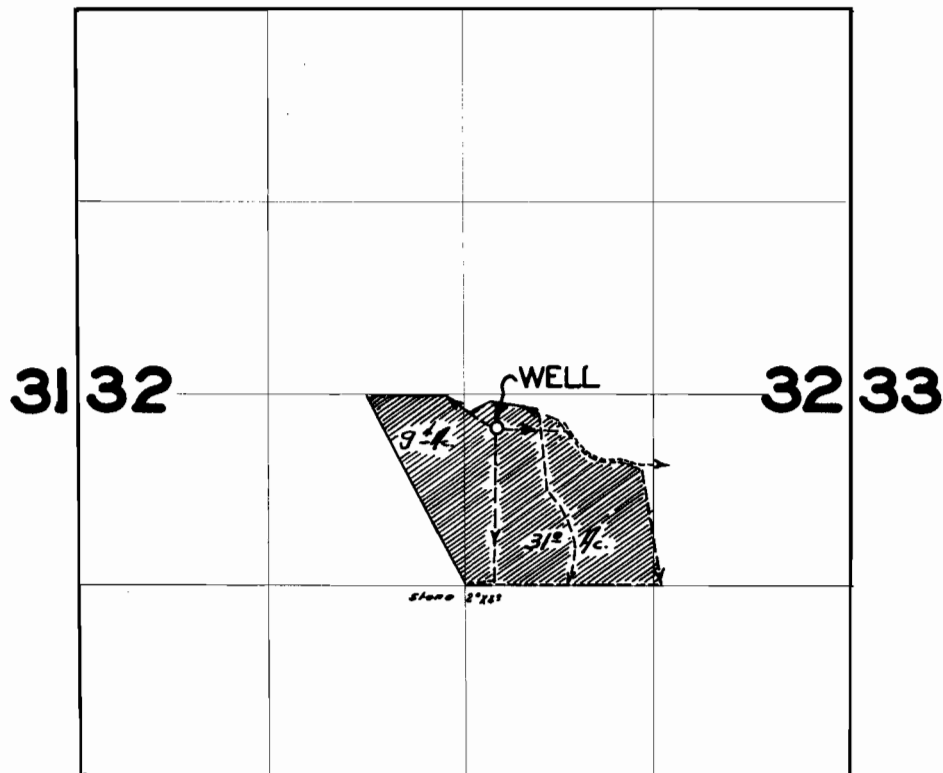

FINAL PROOF SURVEY
UNDER

Application No. U-200 Permit No. U-253
IN NAME OF

JOHN M. SCHOLTES

Surveyed 8/30 1951, by H.L. COFFMAN