


T.16S.R.43E.W.M.

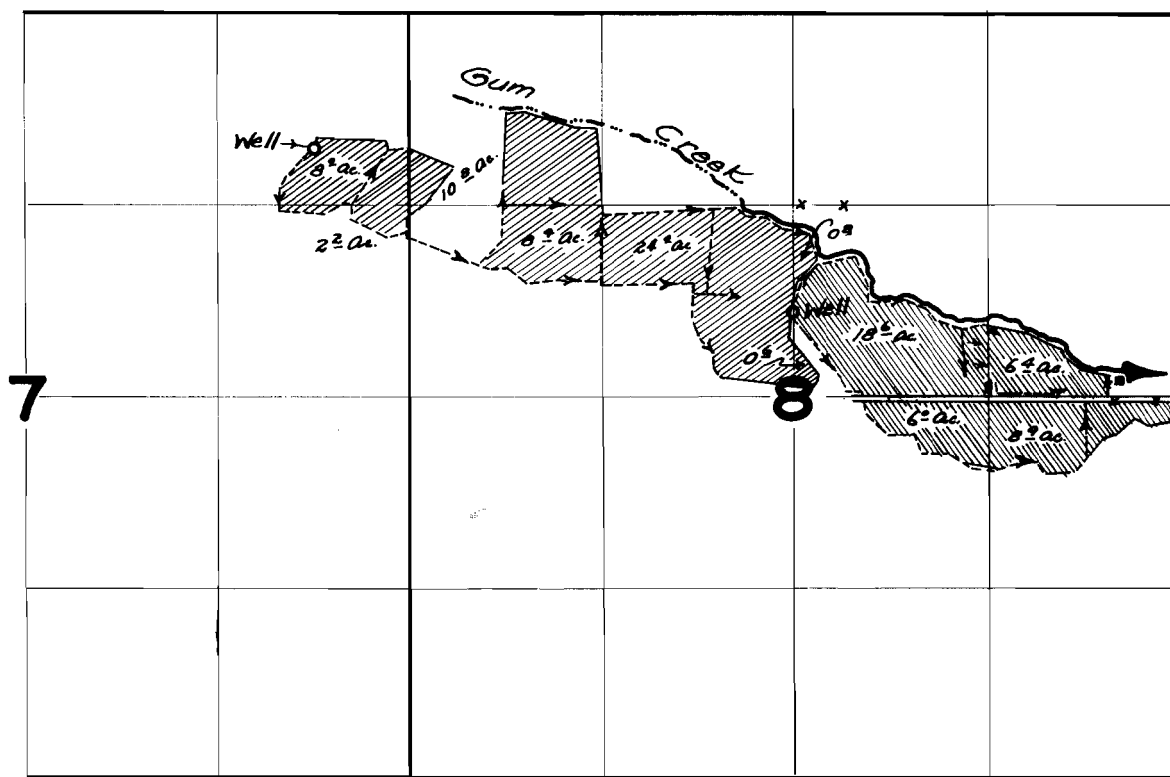

APP. U- 228



APP. U- 229



FINAL PROOF SURVEY

UNDER

U_ 228

U_ 209

Application No. U_ 229

Permit No. U_ 210

IN NAME OF

HERBERT M. SHAW

Surveyed 8/ 30 1951 , by H.L. COFFMAN.