


# T.16S.R.43E.W.M.

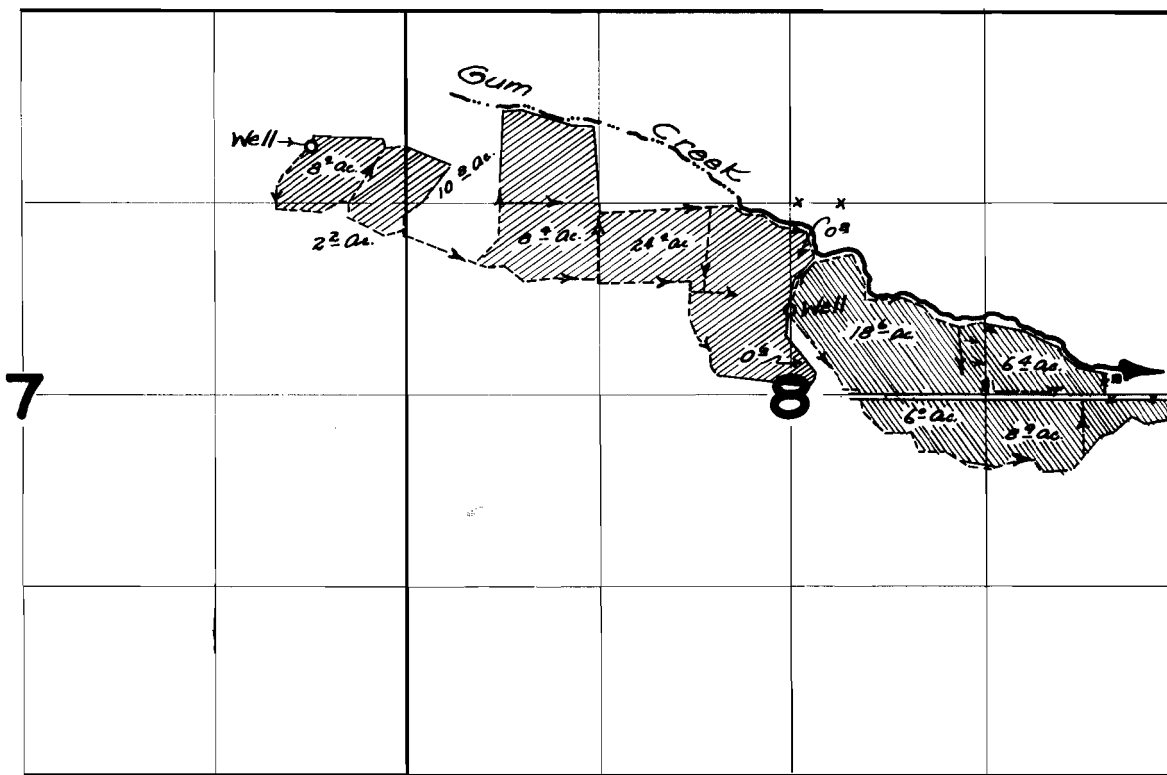

APP. U-228



APP. U-229



## FINAL PROOF SURVEY

UNDER

U-228

U-209

Application No. U-229

Permit No. U-210

IN NAME OF

HERBERT M. SHAW

Surveyed 8/30, 1951, by H.L. COFFMAN.