


# T.17S.R.47E.W.M.

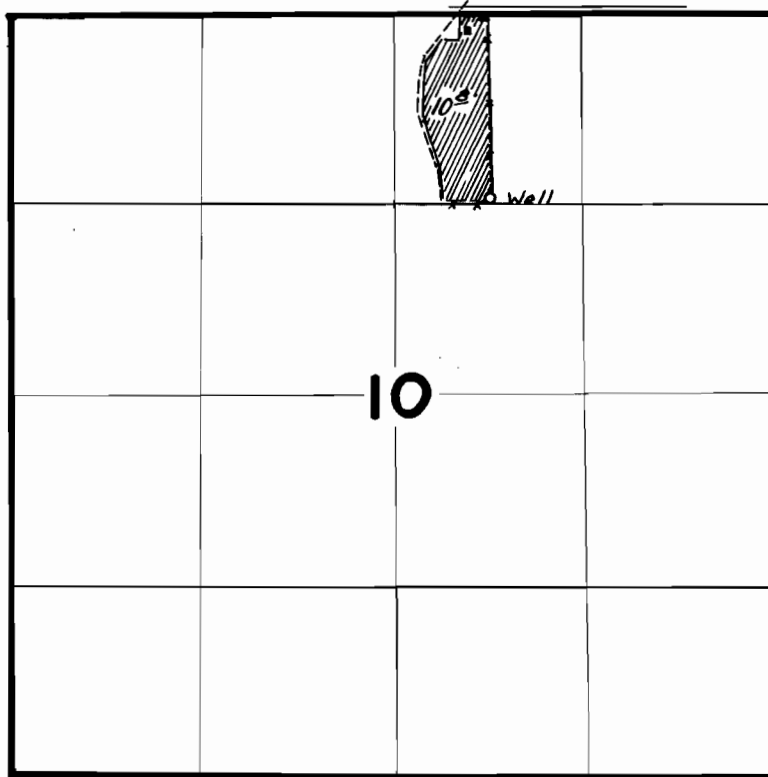

## FINAL PROOF SURVEY

UNDER

Application No U-270 Permit No. U-242

IN NAME OF

MRS. GLENN SCOTT

Surveyed 8/28 1951, by H.L. COFFMAN