


T.15S.R.43E.W.M.

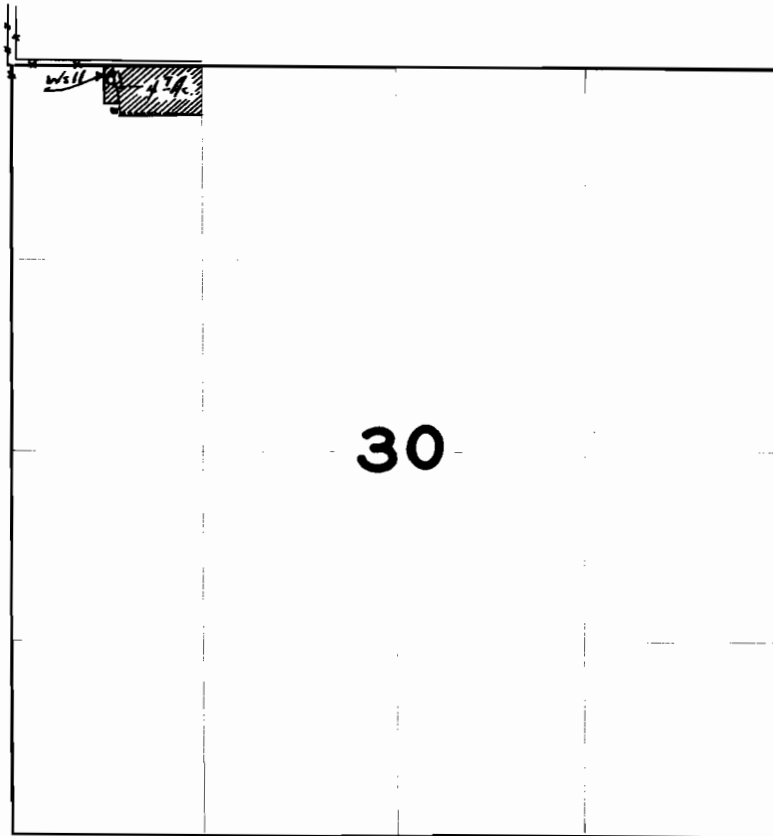

FINAL PROOF SURVEY

UNDER

Application No. U. 353... Permit No. U. 332

IN NAME OF

..... NEIL E. DAWSON

Surveyed 8/29... 1951... by H.L. COFFMAN