


T.1N.R.4E.W.M.

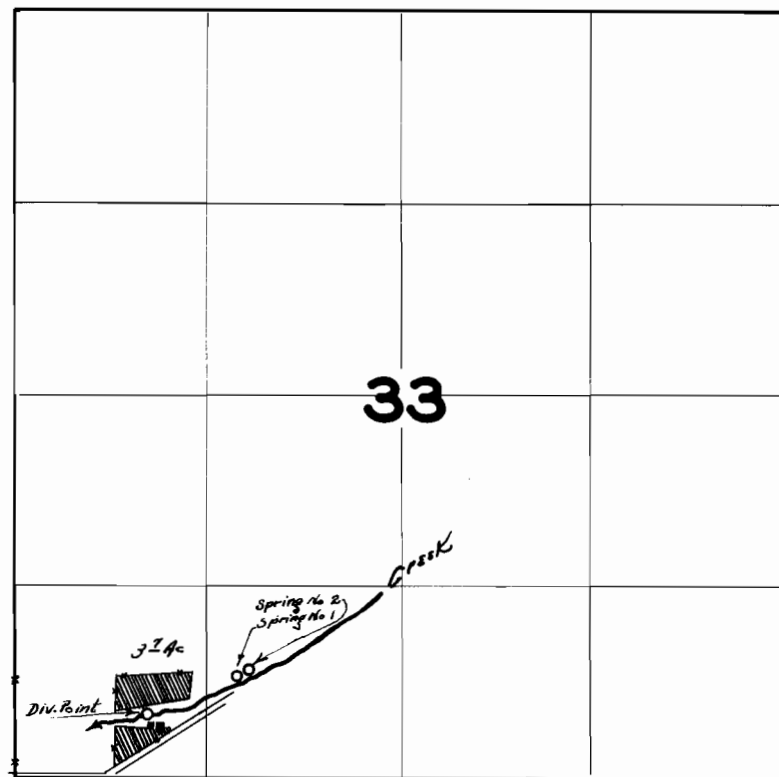

FINAL PROOF SURVEY
UNDER

Application No. 14221 ... Permit No. 10278...
IN NAME OF

G.W. & B.O. BURKE

Surveyed 10/17 ... 1951, by H.L. COFFMAN