


T.2S R.1W.W.M

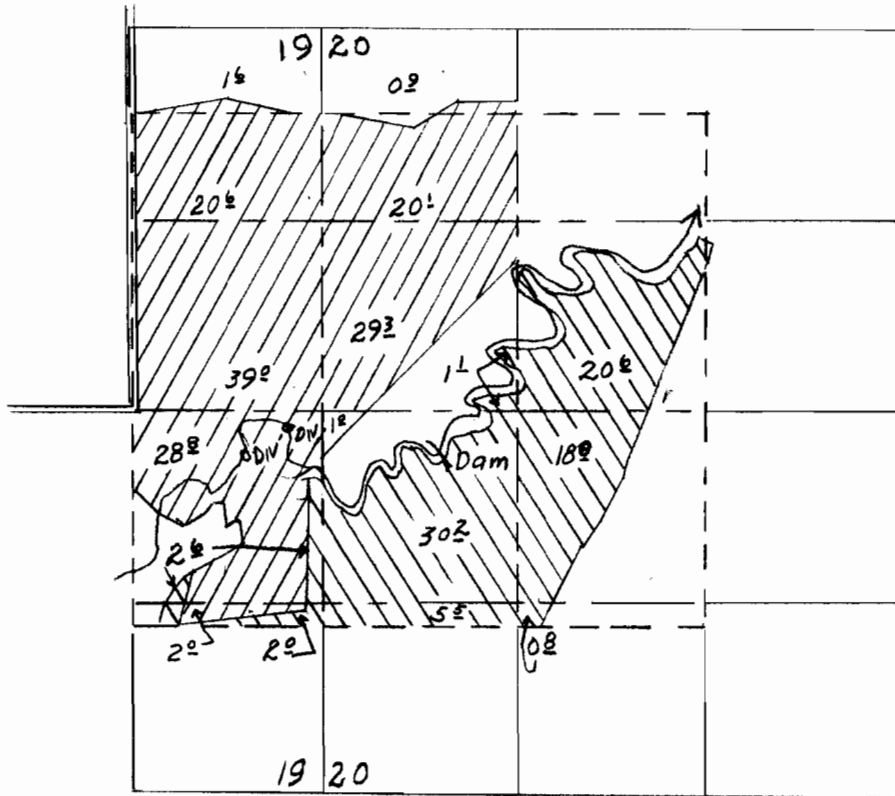

Corrected Map


FINAL PROOF SURVEY
UNDER

Application No 16153 Permit No 11969

Eoff Bros

Surveyed May 9, 1951 by H.L. Coffman

T.2 S. R. 1 W.W.M.

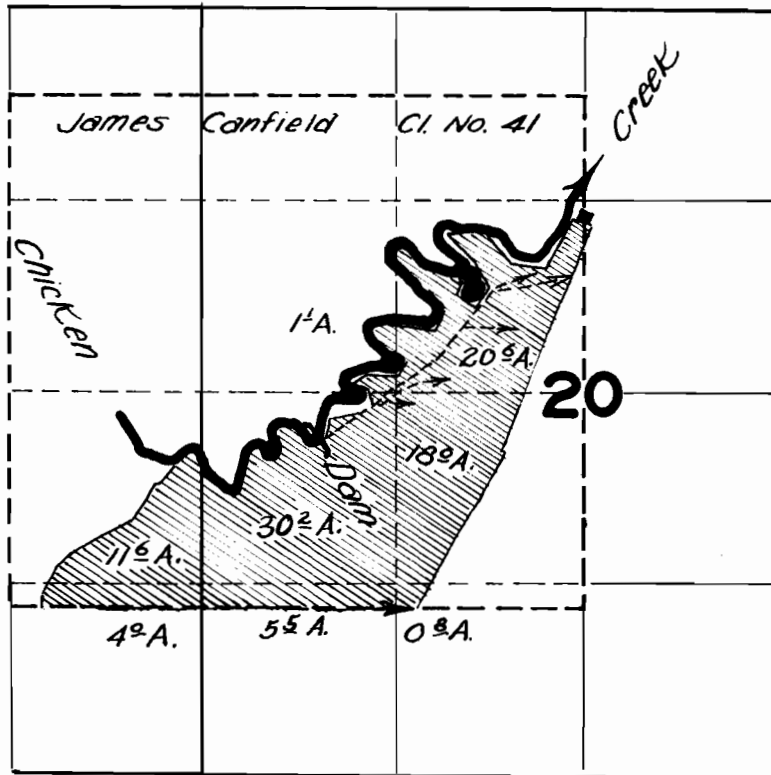

FINAL PROOF SURVEY UNDER

Application No. 16153... Permit No. 11969.

IN NAME OF

..... EOFF BROS.

Surveyed MAY 9 1951., by H.L. COFFMAN.