


T.23S.R.30E.W.M.

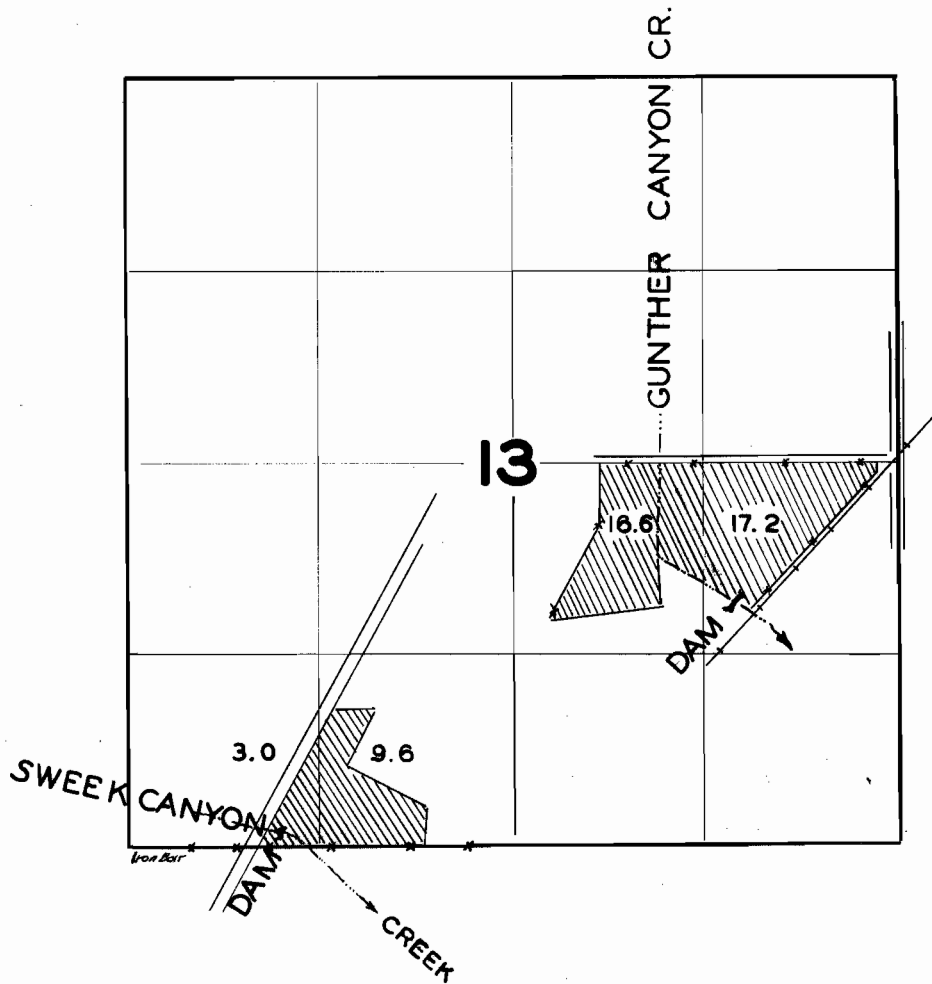

FINAL PROOF SURVEY

UNDER

Application No. 18845 Permit No. 14480

IN NAME OF

ARCHIE MCGOWAN

Surveyed 7/18 1951, by H.L. COFFMAN