


T.2S.R.2W.W.M

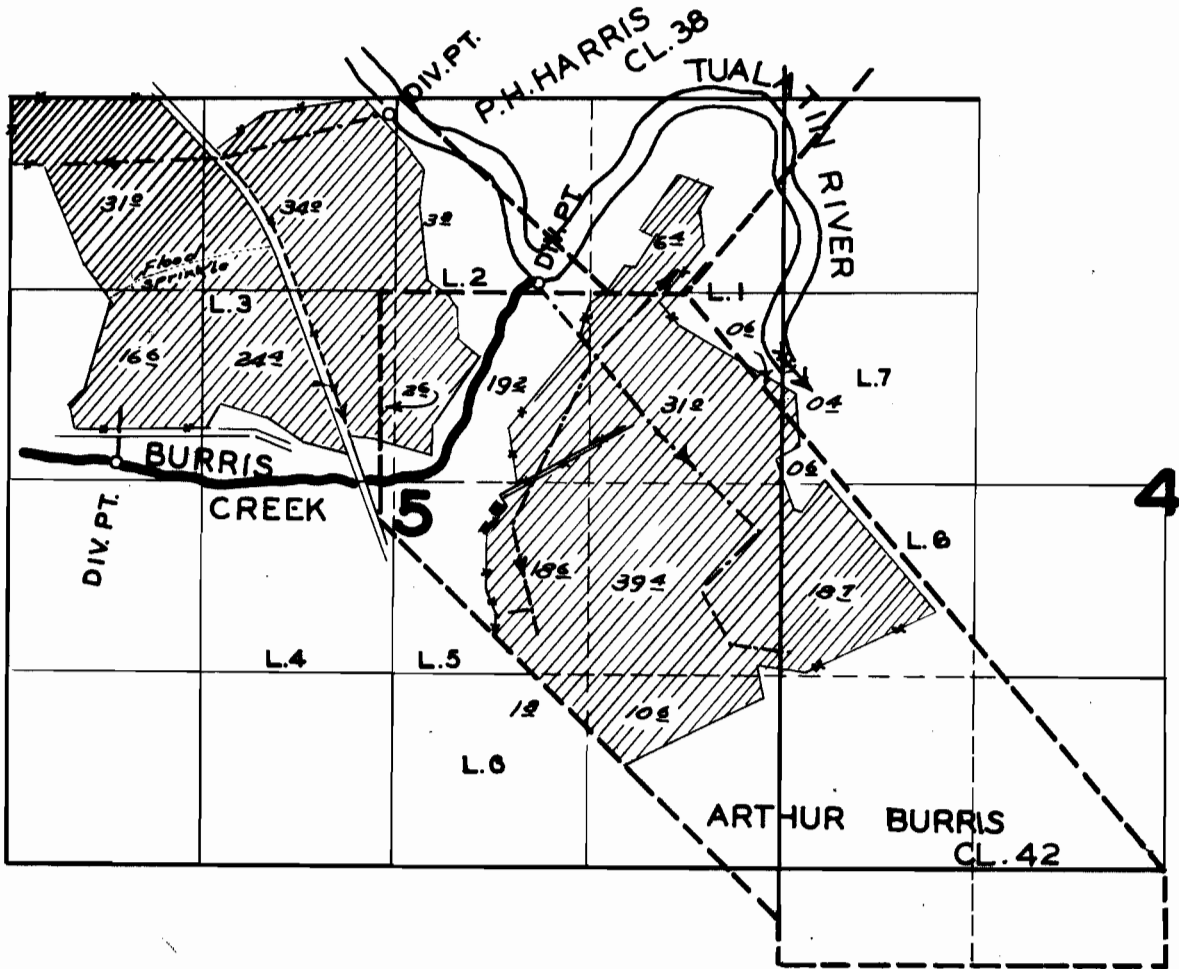

FINAL PROOF SURVEY

UNDER

16499

12297

Application No. 1802.B. Permit No. 13696

IN NAME OF

JULIUS CHRISTENSEN

Surveyed 7/2, 1951, by H.L. COFFMAN