


T.I.O.S.R. I E.W.M.

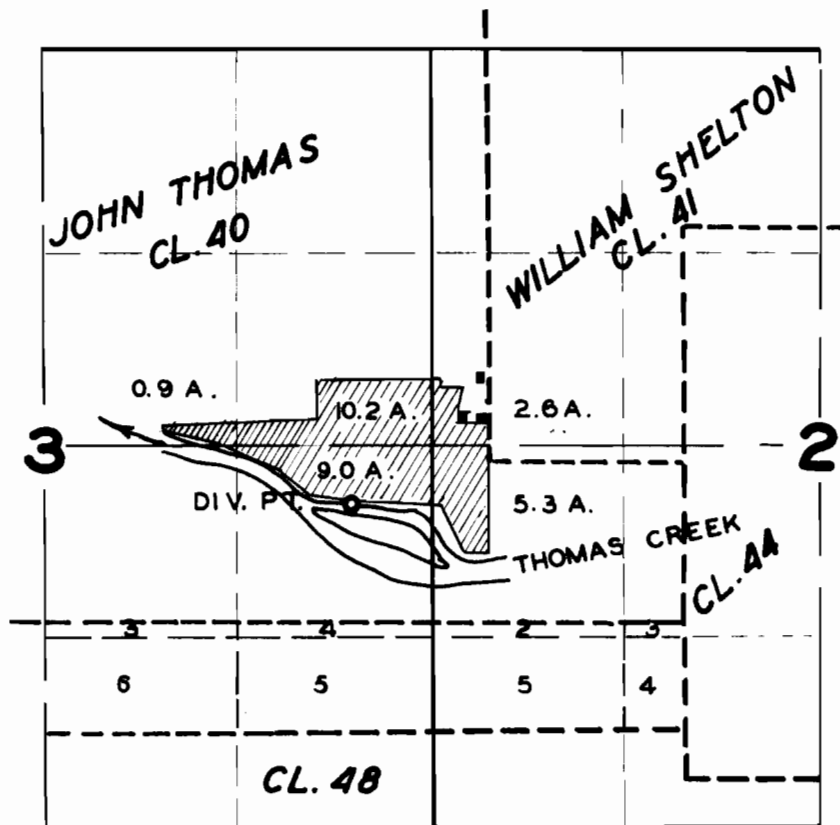

FINAL PROOF SURVEY

UNDER

Application No. 17790 Permit No. 13469

IN NAME OF

JOHN SILBERNAGEL

Surveyed APR. 11, 1951, by H.L. COFFMAN