


T.2N.R.4W.W.M.

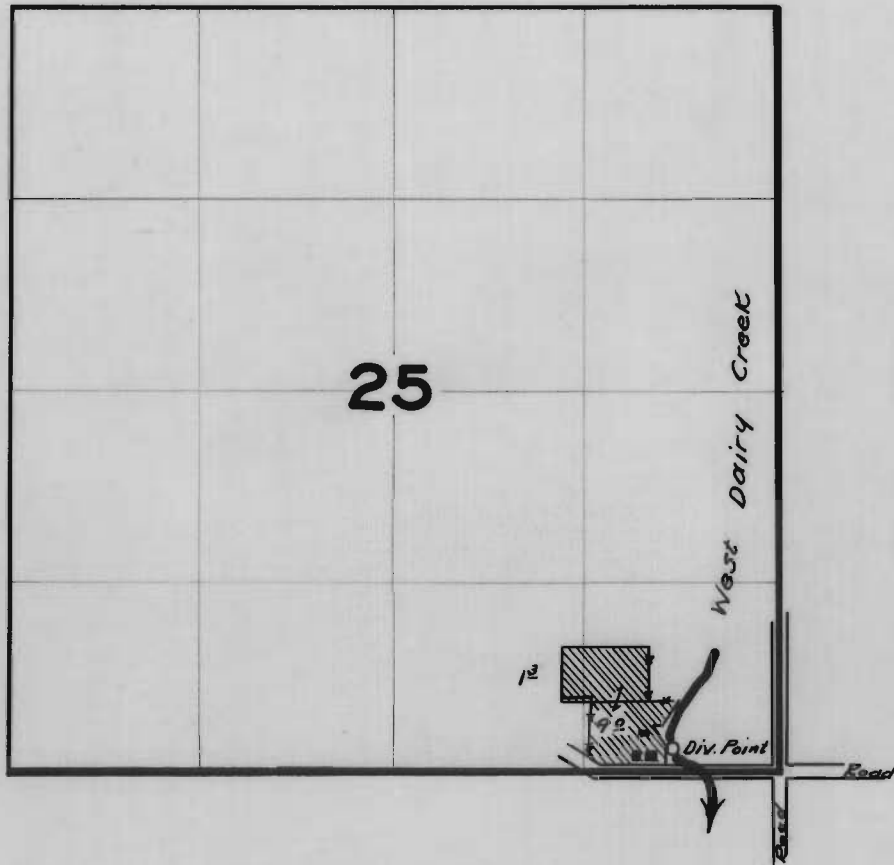

**FINAL PROOF SURVEY**  
UNDER

Application No. **18062** ... Permit No. **13729** ...  
IN NAME OF

..... **ED PAETCH** .....

Surveyed **AUG. 16** 1951, by **H.L. COFFMAN** ..