


# T3S.R.5W.W.M.

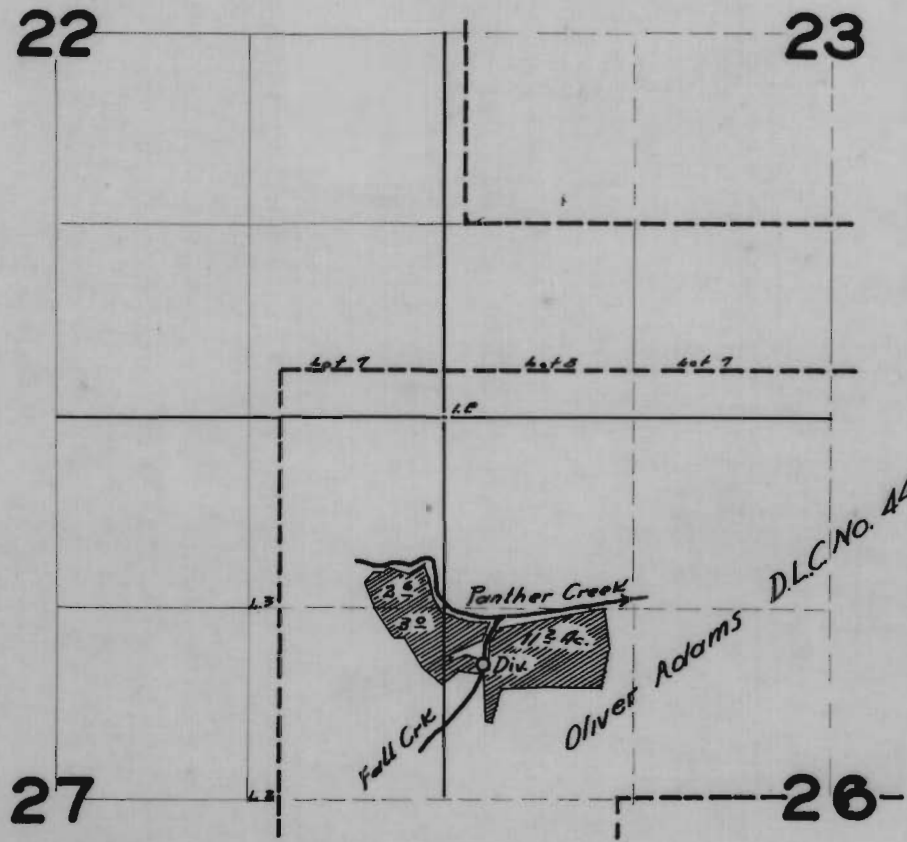

## FINAL PROOF SURVEY

UNDER

Application No. 16614... Permit No. 12397.

IN NAME OF

OTTO SITTON

Surveyed 10/5... 1951., by H.L. COFFMAN