


**T.4S.R.6W.W.M.**

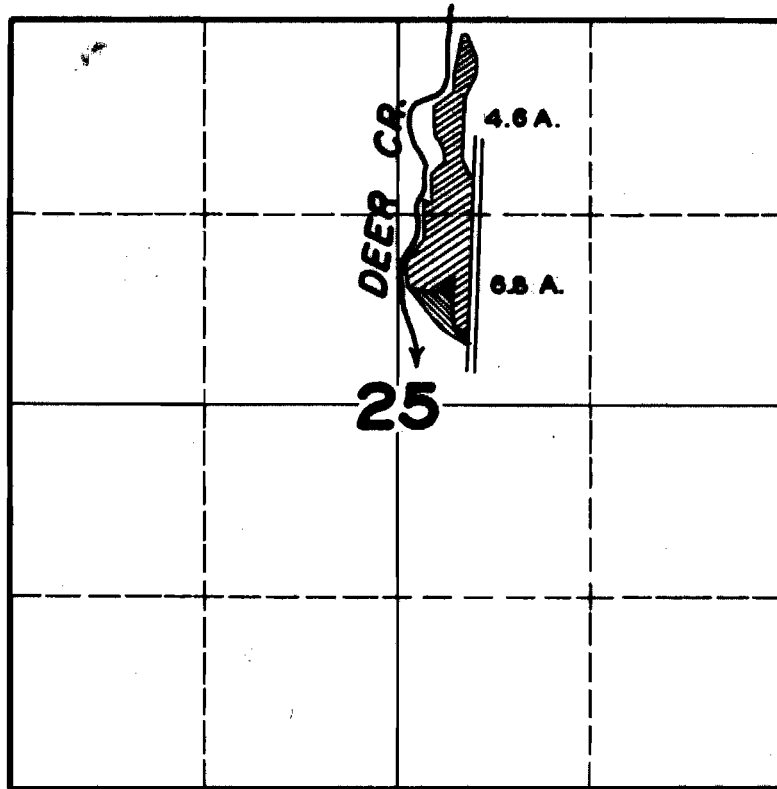

**FINAL PROOF SURVEY**  
UNDER

Application No. 15974... Permit No. 11803...  
IN NAME OF

**FRANK A. LINGSCHUIT**

Surveyed **AUG. 20 1948**, by **JAS. E. BUNNELL**